


STATE OF KANSAS
STATE CORPORATION COMMISSION

WELL PLUGGING RECORD

Give All Information Completely
Make Required Affidavit
Mail or Deliver Report to
Conservation Division
State Corporation Comm.
245 North Water
Wichita, KS 67202

Clark County. Sec. 26 Twp. 34 Rge. 25 E/W
Location as "NE/CNW $\frac{1}{4}$ SW $\frac{1}{4}$ " or footage from lines
1250' FNL & FWL
Lease Owner Wells Energy Company
Lease Name Theis Well No. 1
Office Address 700 S. Colorado, Wuite 454, Denver, Co. 80222
Character of Well (Completed as Oil, Gas or Dry Hole)
Dry Hole
Date Well completed 9-24 1979
Application for plugging filed 9-24 1979
Application for plugging approved 9-24 1979
Plugging commenced 9-24 1979
Plugging completed 9-25 1979
Reason for abandonment of well or producing formation

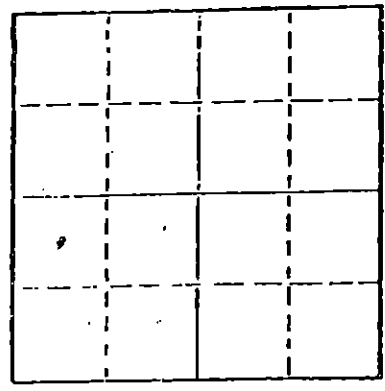

Locate well correctly on above
Section Plat

If a producing well is abandoned, date of last production 19

Was permission obtained from the Conservation Division or its agents before plugging was commenced? YES

Name of Conservation Agent who supervised plugging of this well Bill Owen
Producing formation Depth to top Bottom Total Depth of Well
Show depth and thickness of all water, oil and gas formations.

OIL, GAS OR WATER RECORDS

CASING RECORD

FORMATION	CONTENT	FROM	TO	SIZE	PUT IN	PULLED OUT
		0	756	8 5/8	17 jts.	

Describe in detail the manner in which the well was plugged, indicating where the mud fluid was placed and the method or methods used in introducing it into the hold. If cement or other plugs were used, state the character of same and depth placed, from feet to feet for each plug set.

Cement at 700' with 50 sacks and at 50' with 12 sacks.

RECEIVED
STATE CORPORATION COMMISSION
OCT - 5 1979
CONSERVATION DIVISION
WICHITA, KANSAS

(If additional description is necessary, use BACK of this sheet)

Name of Plugging Contractor Halliburton

STATE OF KANSAS COUNTY OF SEDGWICK, ss.
Kirby C. Evers (employee of owner) or (owner or operator)
of the above-described well, being first duly sworn on oath, says: That I have knowledge of the facts, statements, and matters herein contained and the log of the above-described well as filed and that the same are true and correct. So help me God.

(Signature) Kirby C. Evers
(Address)

SUBSCRIBED AND SWORN TO before me this 4th day of October, 1979

Sharon L. Talburt
Notary Public.

My commission expires 8-13-83

