

STATE OF KANSAS  
STATE CORPORATION COMMISSION

Form CP-4


Give All Information Completely  
Make Required Affidavit  
Mail or Deliver Report to:  
Conservation Division  
State Corporation Commission  
212 No. Market  
Wichita, Kansas

WELL PLUGGING RECORD

Clark County, Sec. 24 Twp. 34S Rge. (E) 25 (W)

Location as "NE/CNW%SW%" or footage from lines C SE SW  
Lease Owner Kathol Petroleum, Inc.  
Lease Name Cox Well No. 1  
Office Address 900 Sutton Place, Wichita, Kansas 67202  
Character of Well (completed as Oil, Gas or Dry Hole) Dry  
Date well completed ~~XXXXXXXXXX~~ 19 71  
Application for plugging filed 19  
Application for plugging approved 19  
Plugging commenced August 31, 19 71  
Plugging completed September 4, 19 71  
Reason for abandonment of well or producing formation

NORTH

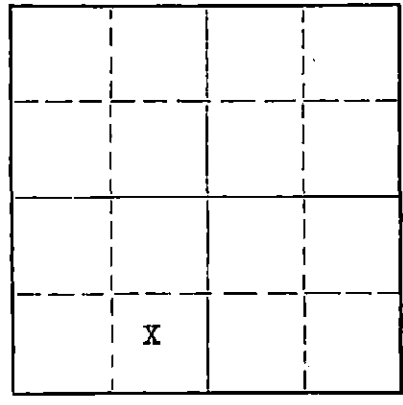

Locate well correctly on above Section Plat

If a producing well is abandoned, date of last production 19  
Was permission obtained from the Conservation Division or its agents before plugging was commenced? Yes

Name of Conservation Agent who supervised plugging of this well  
Producing formation Depth to top Bottom Total Depth of Well 5800 Feet  
Show depth and thickness of all water, oil and gas formations.

OIL, GAS OR WATER RECORDS

CASING RECORD

FORMATION	CONTENT	FROM	TO	SIZE	PUT IN	PULLED OUT
				5 1/2	5800	4761
				8 5/8	1243	None

Describe in detail the manner in which the well was plugged, indicating where the mud fluid was placed and the method or methods used in introducing it into the hole. If cement or other plugs were used, state the character of same and depth placed, from feet to feet for each plug set.

Spotted 25 sack cement plug by pump method displaced with mud to 5100', shot off pipe at 4731', pulled pipe to 1200', spotted 45 sack cement plug to 1200', spotted 15 sack cement plug from 3' to 45', welded cap on top.

RECEIVED  
STATE CORPORATION COMMISSION  
SEP 10 1971  
CONSERVATION DIVISION  
Wichita, Kansas


(If additional description is necessary, use BACK of this sheet)

Name of Plugging Contractor Lillard Casing Pulling, Inc.  
Address P. O. Box 962, Woodward, Oklahoma 73801

STATE OF Kansas, COUNTY OF Sedgwick, ss.  
Kathol Petroleum, Inc. (employee of owner) or (owner or operator) of the above-described well, being first duly sworn on oath, says: That I have knowledge of the facts, statements, and matters herein contained and the log of the above-described well as filed and that the same are true and correct. So help me God.

(Signature) Jack L. Keane  
KATHOL PETROLEUM, INC.  
By: Jack L. Keane, Vice President  
(Address)

9th day of September, 19 71

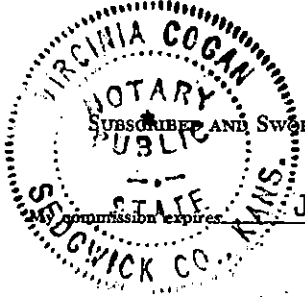

Virginia Cogan  
Notary Public.

DRILLERS LOG

#1 COX

CASING RECORD:	OPERATOR:	W.P. CARR & KPI	DESCRIPTION:
13-3/8" @ 75' w/ 175 sacks cem.	CONTRACTOR:	Kathol Petroleum, Inc.	C. SE SW Sec. 24-34S-25W Clark County, Kansas
8-5/8" @ 1243' w/ 500 sacks cem.	COMMENCED:	June 28, 1971	ELEVATION: 2028' K.B.
5-1/2" @ 5796 w/ 200 sacks cem.	COMPLETED:	July 13, 1971	I.P. Dry & Abandoned
	TOTAL DEPTH:	5800'	

<u>FORMATION:</u>	<u>FROM:</u>	<u>TO:</u>	<u>REMARKS:</u>
surface hole	0	75	
sand & shale	75	675	
shale & sand	675	1100	
shale & sand	1100	1243	
red bed & shale	1243	1335	
shale & shells	1335	1989	
shells & shale	1989	2185	
shale & lime	2185	2370	
shale & lime	2370	2565	
shale & lime	2565	2750	
shale & lime	2750	2925	
shale & lime	2925	3175	
shale & lime	3175	3385	
lime & shale	3385	3550	
lime & shale	3550	3700	
lime & shale	3700	3875	
lime & shale	3875	4030	
lime & shale w/chert strks.	4030	4175	
shale & lime	4175	4350	
lime & shale	4350	4520	
lime & shale	4520	4665	
lime & shale	4665	4815	
lime	4815	4950	
lime & chert strks.	4950	5045	
lime	5045	5135	
lime	5135	5185	
lime	5185	5235	
lime & shale	5235	5325	
lime	5325	5420	
lime	5420	5510	
lime	5510	5587	
lime & chert	5587	5685	
lime & chert	5685	5775	
lime & shale	5775	5800 R.T.D.	


STATE RECEIVED  
 AUG 23 1971  
 CONSERVATION DIVISION  
 Wichita, Kansas

I hereby certify that the above information is true and correct to the best of my knowledge.

KATHOL PETROLEUM, INC.

*R. A. Beutel*  
 R. A. Beutel, Executive Vice President

Subscribed and sworn to before me this 19 day of August, 1971.

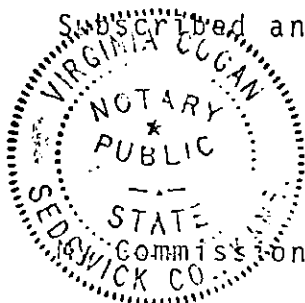

*Virginia Cogan*  
 Virginia Cogan, Notary Public

Commission Expires: June 4, 1975