

STATE OF KANSAS
STATE CORPORATION COMMISSION

WELL PLUGGING RECORD

Give All Information Completely
Make Required Affidavit
Mail or Deliver Report to:
Conservation Division
State Corporation Commission
211 No. Broadway
Wichita, Kansas

Meade County, Sec. 8 Twp. 34S Rge. 27W (E) (W)

Location as "NE/CNW%SW%" or footage from lines 1390' fr. S line & 20' W of E line

Lease Owner Horizon Oil & Gas Co.

Lease Name THONHOFF Well No. 1-8

Office Address P.O. Box 7, Spearman, Texas 79081

Character of Well (completed as Oil, Gas or Dry Hole) Dry hole

Date well completed September 14 1965

Application for plugging filed September 16 1965

Application for plugging approved September 15 1965


Plugging commenced September 15 1965

Plugging completed September 15 1965

Reason for abandonment of well or producing formation Dry hole

If a producing well is abandoned, date of last production none 19

Was permission obtained from the Conservation Division or its agents before plugging was commenced? yes

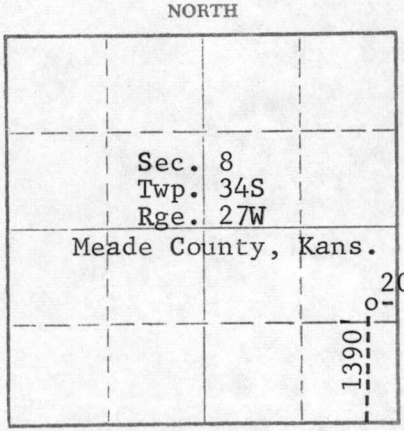

Locate well correctly on above Section Plat

Name of Conservation Agent who supervised plugging of this well Walter Scott

Producing formation none Depth to top - Bottom - Total Depth of Well 6200 Feet

Show depth and thickness of all water, oil and gas formations.

OIL, GAS OR WATER RECORDS

CASING RECORD

FORMATION	CONTENT	FROM	TO	SIZE	PUT IN	PULLED OUT
	 Dry	5101	TD	8-5/8"	1341	NONE

RECEIVED
STATE CORPORATION COMMISSION
SEP 20 1965
CONSERVATION DIVISION
Wichita, Kansas

Describe in detail the manner in which the well was plugged, including where the mud fluid was placed and the method or methods used in introducing it into the hole. If cement or other plugs were used, state the character of same and depth placed, from 700 feet to 15 feet for each plug set.

35 sack plug set at 700', 15 sack plug set at surface. Welded on cap.

(If additional description is necessary, use BACK of this sheet)

Name of Plugging Contractor Halliburton

Address Liberal, Kansas

STATE OF Texas, COUNTY OF Hansford, ss.

Everett R. Tracy (employee of owner) or ~~(owner)~~ of the above-described well, being first duly sworn on oath, says: That I have knowledge of the facts, statements, and matters herein contained and the log of the above-described well as filed and that the same are true and correct. So help me God.

(Signature) Everett R. Tracy

P.O. Box 7, Spearman, Texas 79081
(Address)

SUBSCRIBED AND SWORN TO before me this 16th day of September, 1965

My commission expires June 1, 1966

Jessie Garcia
Hansford County, Texas Notary Public.

