


WELL PLUGGING RECORD

Give All Information Completely
Make Required Affidavit
Mail or Deliver Report to:
Conservation Division
State Corporation Commission
211 No. Broadway
Wichita, Kansas

Meade County, Sec. 5 Twp. 34 Rge. 29W (E) (W)

Location as "NE/CNW/SW" or footage from lines se nw
Lease Owner Thomas and Brewer
Lease Name Adams Well No. 2-5
Office Address Drawer 1177 Liberal, Kansas
Character of Well (completed as Oil, Gas or Dry Hole) Dry Hole
Date well completed 4-22-64 19
Application for plugging filed 5-27-64 19
Application for plugging approved 6-2 19 64
Plugging commenced 6-8 19 64
Plugging completed 6-10 19 64
Reason for abandonment of well or producing formation Non-producer

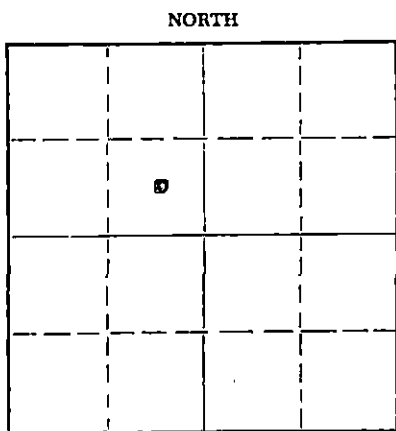

Locate well correctly on above
Section Plat

If a producing well is abandoned, date of last production _____ 19____
Was permission obtained from the Conservation Division or its agents before plugging was commenced? Yes

Name of Conservation Agent who supervised plugging of this well Hugh Scott
Producing formation Morrow Depth to top 5849' Bottom 5910' Total Depth of Well 6000' Feet
Show depth and thickness of all water, oil and gas formations.

OIL, GAS OR WATER RECORDS

CASING RECORD

FORMATION	CONTENT	FROM	TO	SIZE	PUT IN	PULLED OUT
				8 5/8	1484	None
				4 1/2"	5906	5144

Describe in detail the manner in which the well was plugged, indicating where the mud fluid was placed and the method or methods used in introducing it into the hole. If cement or other plugs were used, state the character of same and depth placed, from _____ feet to _____ feet for each plug set.

Pump 20 sks cement to plug off perforations and stop plug at 5700'. Fill hole with mud to 700' and pump 35 sacks cement at 700' to 600'. Mud to 45' and 15 sacks cement 45' to base of cellar. Cut 8 5/8 off 3' below ground level and weld cap on same.

RECEIVED
STATE CORPORATION COMMISSION

JUL 1 1964

CONSERVATION DIVISION
Wichita, Kansas

(If additional description is necessary, use BACK of this sheet)

Name of Plugging Contractor Sargents Casing Pulling Service
Address Box 506 Liberal, Kansas

STATE OF Kansas, COUNTY OF Seward, ss.
Delvin P. Luck (employee of owner) or (owner or operator) of the above-described well, being first duly sworn on oath, says: That I have knowledge of the facts, statements, and matters herein contained and the log of the above-described well as filed and that the same are true and correct. So help me God.

(Signature) Delvin P. Luck
Drawer 1177 Liberal, Kansas
(Address)

SUBSCRIBED AND SWORN to before me this 30th day of June, 19 64

My commission expires 11-5-66

Markus Kesting
Notary Public.



15-119-00225-0000

SE NW
Sec. 5-34S-29W
Meade County, Kansas

ADAMS WELL NO. 2-5

CONTRACTOR: The R. W. Rine Drilling Company

STARTED: February 23, 1963

COMPLETED: March 12, 1963

	L	O	G
Sand & Shells	0'	-	186'
Sand & Gyp	186'	-	500'
Red Bed	500'	-	1120'
Red Bed & Shale	1120'	-	1408'
Anhydrite	1408'	-	1490'
Red Bed & Anhydrite	1490'	-	2205'
Anhydrite & Shale	2205'	-	2424'
Shale & Lime	2424'	-	3012'
Lime	3012'	-	3178'
Lime & Shale	3178'	-	3342'
Lime, Shale & Chalk	3342'	-	3588'
Lime & Shale	3588'	-	3754'
Shale	3754'	-	4440'
Lime & Shale	4440'	-	4984'
Lime	4984'	-	5650'
Lime & Shale	5650'	-	5717'
Lime	5717'	-	5878'
Lime & Sand	5878'	-	5903'
Lime & Shale	5903'	-	5940'
Lime	5940'	-	6005'

Totco @1480', 1/2°
8-5/8" Csg. @1484' W/450 Sx.
Lt. Wt. Followed w/200 sx. Reg.
all with 2% C.C.

Totco @2670', 3/4°

Totco @3340', 1°

Totco @4150', 3/4°

Totco @4475', 1-1/2°

Totco @5065', 2°; @5645', 2°

T. D. 4-1/2" Csg. @5960'
w/150 Sx.

STATE OF KANSAS)
COUNTY OF SEDGWICK) ss

I, R. M. Green, do hereby certify that the above is a true and accurate log of the Adams Well No. 2-5, located SE NW of Section 5-34S-29W, Meade County, Kansas.


Secretary-Treasurer

Subscribed and sworn to before me this 18th day of March, 1963.


Notary Public

My Commission Expires: 6/14/66

RECEIVED
STATE CORPORATION COMMISSION

JUL 1 1964

CONSERVATION DIVISION
Wichita, Kansas