

STATE OF KANSAS
STATE CORPORATION COMMISSION


Give All Information Completely
Make Required Affidavit
Mail or Deliver Report to:
Conservation Division
State Corporation Commission
211 No. Broadway
Wichita, Kansas

WELL PLUGGING RECORD

Clark County, Sec. 3 Twp. 34S Rge. 22W (d) (W)

Location as "NE/CNW%SW%" or footage from lines G SE/4
Lease Owner Graham-Michaelis Drilling Company
Lease Name McMinimy Well No. 1-3
Office Address 211 N. Broadway, Wichita, Kansas 67202
Character of Well (completed as Oil, Gas or Dry Hole) Dry Hole
Date well completed May 3, 19 65
Application for plugging filed (verbal) May 3, 19 65
Application for plugging approved (verbal) May 3, 19 65
Plugging commenced May 3, 19 65
Plugging completed May 3, 19 65
Reason for abandonment of well or producing formation Dry Hole

NORTH

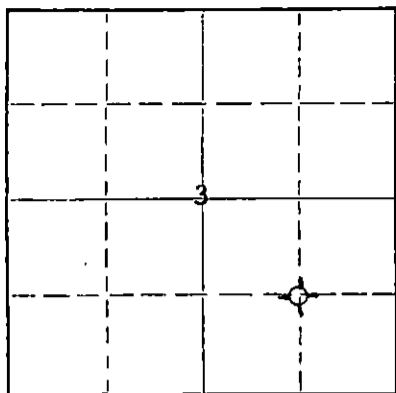

Locate well correctly on above Section Plat

If a producing well is abandoned, date of last production ----- 19____
Was permission obtained from the Conservation Division or its agents before plugging was commenced? yes

Name of Conservation Agent who supervised plugging of this well Hugh Scott, Box F, Sublette, Kansas
Producing formation ----- Depth to top --- Bottom ----- Total Depth of Well 5525 Feet
Show depth and thickness of all water, oil and gas formations.

OIL, GAS OR WATER RECORDS

CASING RECORD

FORMATION	CONTENT	FROM	TO	SIZE	PUT IN	PULLED OUT
				8 5/8"	627'	none

Describe in detail the manner in which the well was plugged, indicating where the mud fluid was placed and the method or methods used in introducing it into the hole. If cement or other plugs were used, state the character of same and depth placed, from _____ feet to _____ feet for each plug set.

Filled hole with heavy drilling mud. Cement plug (35 sx cement) at 627'.
Filled hole with heavy drilling mud. Cement plug (15 sx cement) at 45'.
Filled hole with heavy drilling mud. 2 sacks cement in rat hole.

RECEIVED
STATE CORPORATION COMMISSION

MAY 11 1965

CONSERVATION DIVISION
Wichita, Kansas

(If additional description is necessary, use BACK of this sheet)

Name of Plugging Contractor Graham-Michaelis Drilling Company
Address 211 North Broadway, Wichita, Kansas 67202


STATE OF Kansas, COUNTY OF Sedgwick, ss.
John L. James (employee of owner) of the above-described well, being first duly sworn on oath, says: That I have knowledge of the facts, statements, and matters herein contained and the log of the above-described well as filed and that the same are true and correct. So help me God.

(Signature) John L. James - Geologist
211 North Broadway, Wichita, Kansas 67202 (Address)

SUBSCRIBED AND SWORN TO before me this 4th day of May, 19 65

Evelyn D. Evans Notary Public.

My commission expires December 12, 1966

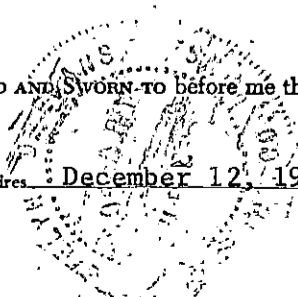

McMind # 1-3

Well Record:

Location : 100' S E C S E/4 Section 3-34S- 22W
 Clark County, Kansas
 Commenced 4-20-65
 Completed 5-3-65
 (Rotary)

Contractor : Graham-Michaelis Drilling, Inc.
 Liberal Division
 Box 1294
 Liberal, Kansas

Log

RECEIVED
 STATE CORPORATION COMMISSION
 MAY 11 1965
 CONSERVATION DIVISION
 Wichita, Kansas

Sand & Red Bed	0 - 217
Red Bed	217 - 844
Red Bed & Shale	844 - 1756
Lime & Shale	1756 - 4568
Lime	4568 - 4621
Lime & Shale	4621 - 4828
Lime	4828 - 4919
Lime & Shale	4919 - 5050
Lime	5050 - 5113
Lime & Shale	5113 - 5135
Lime	5135 - 5173
Lime & Shale	5173 - 5273
Lime	5273 - 5525

5525 Total Rotary Depth

The undersigned, Graham-Michaelis Drilling, Inc., Liberal Division, certifies that the above log is a true and correct copy of the formations encountered in drilling the above mentioned well, as taken from the Daily Drilling Report.

Graham-Michaelis Drilling, Inc.
Liberal Division

By H.R. Michaelis
H.R. Michaelis