


STATE OF KANSAS
STATE CORPORATION COMMISSION

WELL PLUGGING RECORD

Give All Information Completely
Make Required Affidavit
Mail or Deliver Report to
Conservation Division
State Corporation Comm.
245 North Water
Wichita, KS 67202

Clark County. Sec. 25 Twp. 34S Rge. 22 SW
Location as "NE/CNW $\frac{1}{2}$ SW $\frac{1}{4}$ " or footage from lines _____
N/2 N/2 SW/4 Sec. 25-34S-22W
Lease Owner National Oil Company
Lease Name Bentley-Randall Well No. 1
Office Address Suite 550, 200 W. Douglas, Wichita, Ks
Character of Well (Completed as Oil, Gas or Dry Hole) _____

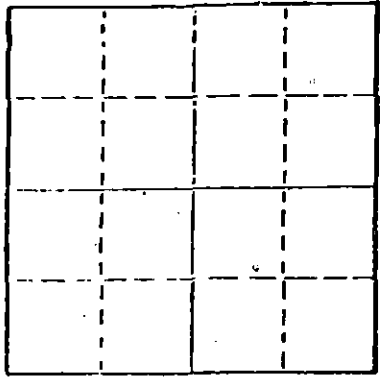

Locate well correctly on above
Section Plat

dry hole
Date Well completed 12-13 1978
Application for plugging filed 12-13 1978
Application for plugging approved 12-13 1978
Plugging commenced 12-13 1978
Plugging completed 12-13 1978
Reason for abandonment of well or producing formation _____
no commercial quantities of oil or gas encountered
If a producing well is abandoned, date of last production
-- 19

Was permission obtained from the Conservation Division or
its agents before plugging was commenced? yes

Name of Conservation Agent who supervised plugging of this well Clarence Thomas
Producing formation _____ Depth to top _____ Bottom _____ Total Depth of Well 5600
Show depth and thickness of all water, oil and gas formations.

OIL, GAS OR WATER RECORDS

CASING RECORD

FORMATION	CONTENT	FROM	TO	SIZE	PUT IN	PULLED OUT
surface hole	shale	surf	812	8-5/8"	804'	none

Describe in detail the manner in which the well was plugged, indicating where the mud fluid
was placed and the method or methods used in introducing it into the hold. If cement or other
plugs were used, state the character of same and depth placed, from _____ feet to
_____ feet for each plug set.

Fluid to 5500', plug, 50 sx
Fluid to 800', plug, 35 sx
Fluid to 40', plug, 10 sx
5 sx in rat hole

RECEIVED
STATE CORPORATION COMMISSION
DEC 22 1978
12-22-78
CONSERVATION DIVISION
Wichita, Kansas

(If additional description is necessary, use BACKS of this sheet)
Name of Plugging Contractor DNB DRILLING, INC.
515 R. H. Garvey Building
Wichita, Kansas 67202

STATE OF Kansas COUNTY OF Sedgewick, ss.
Ella Priess (employee of owner) or (owner or operator)
of the above-described well, being first duly sworn on oath, says: That I have knowledge of
the facts, statements, and matters herein contained and the log of the above-described well
as filed and that the same are true and correct. So help me God.

(Signature) Ella Priess
Suite 515 R. H. Garvey Bldg., Wichita, Ks.
(Address) 67202

SUBSCRIBED AND SWORN TO before me this 14th day of December, 19 78

My commission expires April 30, 1979

Dorothy L. Schmidt
Dorothy L. Schmidt Notary Public.

DOROTHY L. SCHMIDT
STATE NOTARY PUBLIC
Sedgewick County, Kansas
My Appt. Exp. April 30, 1979

DRILLER'S LOG

NATIONAL OIL COMPANY
No. 1 Bentley Randall
N/2 N/2 SW/4 Sec. 25-34S-22W
Clark Co., Ks.

Commenced: 11-28-78
Completed: 12-13-78

Surface Casing: 304' of 8-5/8"
cemented w/400 sx common, top w/100 sx
common

FORMATION

DEPTH

Surface Hole	0 - 812
Shale	812 - 860
Sand & Lime	860 - 1580
Shale & Lime	1580 - 2935
Lime & Shale	2935 - 3395
Shale & Lime	3395 - 3575
Lime & Shale	3575 - 3925
Shale & Lime	3925 - 4015
Lime & Shale	4015 - 4250
Shale	4250 - 4332
Lime & Shale	4332 - 4930
Lime	4930 - 5065
Shale	5065 - 5169
Lime	5169 - 5400
Shale	5400 - 5480
Shale & Lime	5480 - 5580
Lime	5580 - 5600 RTD

I do hereby certify that the foregoing statements are true and correct to the best of my knowledge and belief.

D N B DRILLING, INC.

Ella Priess
Ella Priess

STATE OF KANSAS: ss:

Subscribed and sworn to before me this 15th day of December, 1978

RECEIVED
STATE CORPORATION COMMISSION

DEC 22 1978

CONSERVATION DIVISION
Wichita, Kansas

Dorothy L. Schmidt
Dorothy L. Schmidt, Notary Public

DOROTHY L. SCHMIDT
STATE NOTARY PUBLIC
Sedgwick County, Kansas
My Appt. Exp. April 30, 1979