


STATE OF KANSAS  
STATE CORPORATION COMMISSION

WELL PLUGGING RECORD

Give All Information Completely  
Make Required Affidavit

Mail or Deliver Report to:  
Conservation Division  
State Corporation Commission  
800 Bitting Building  
Wichita, Kansas

NORTH

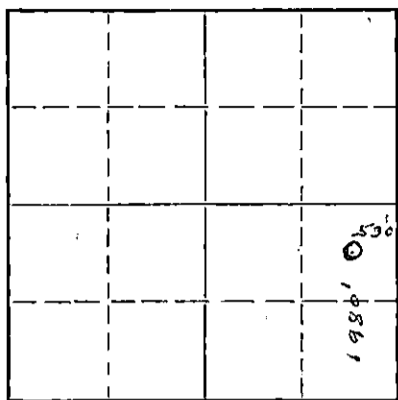

Locate well correctly on above  
Section Plat

Clark County. Sec. 25 Twp. 34S Rge. (E) 22 (W)  
Location as "NE/CNW4SW4" or footage from lines 530' W of E line-1980' N of S Line  
Lease Owner Falcon Seaboard Drilling Company  
Lease Name Randall Well No. 4  
Office Address Pan American Building, Tulsa, Oklahoma  
Character of Well (completed as Oil, Gas or Dry Hole) Dry Hole  
Date well completed January 14, 19 61  
Application for plugging filed January 14, 19 61  
Application for plugging approved 19  
Plugging commenced January 14, 19 61  
Plugging completed January 14, 19 61  
Reason for abandonment of well or producing formation

If a producing well is abandoned, date of last production 19  
Was permission obtained from the Conservation Division or its agents before plugging was commenced? Yes

Name of Conservation Agent who supervised plugging of this well W. L. Lac Kamp, Jr.  
Producing formation Depth to top Bottom Total Depth of Well 5570 Feet  
Show depth and thickness of all water, oil and gas formations.

OIL, GAS OR WATER RECORDS

CASING RECORD

FORMATION	CONTENT	FROM	TO	SIZE	PUT IN	PULLED OUT
				13-3/8"	193	None
				7	2470	None

Describe in detail the manner in which the well was plugged, indicating where the mud fluid was placed and the method or methods used in introducing it into the hole. If cement or other plugs were used, state the character of same and depth placed, from feet to feet for each plug set.

Hole was full of mud. Set 20 sacks cement @ 2398';  
Set 20 sacks cement @ 518';  
Set 10 sacks cement @ 30'.

Pumped and displaced by Halliburton Company.

RECEIVED  
STATE CORPORATION COMMISSION  
JAN 21 1961  
1-25-61  
CONSERVATION DIVISION  
Wichita, Kansas

(If additional description is necessary, use BACK of this sheet)  
Name of Plugging Contractor Herndon Drilling Company  
Address Tulsa, Oklahoma

STATE OF OKLAHOMA, COUNTY OF TULSA, ss.  
I. O. Brown (employee of owner) or (owner or operator) of the above-described well, being first duly sworn on oath, says: That I have knowledge of the facts, statements, and matters herein contained and the log of the above-described well as filed and that the same are true and correct. So help me God.

(Signature) I. O. Brown  
805 Pan American Bldg., Tulsa, Oklahoma  
(Address)

SUBSCRIBED AND SWORN to before me this 18th day of January, 19 61

My commission expires April 6, 1963

Catherine Donohoe  
Notary Public.

