


STATE OF KANSAS
STATE CORPORATION COMMISSION

WELL PLUGGING RECORD

Give All Information Completely
Make Required Affidavit
Mail or Deliver Report to
Conservation Division
State Corporation Comm.
245 North Water
Wichita, KS 67202

Clark County, Sec. 24 Twp. 34S Rge. 22W E/W
Location as "NE/CNW $\frac{1}{4}$ SW $\frac{1}{4}$ " or footage from lines NW SW NE

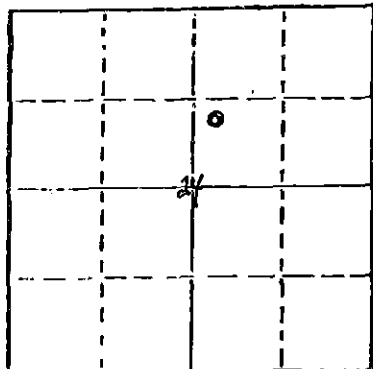

Locate well correctly on above
Section Plat

Lease Owner Beren Corporation
Lease Name Randall Well No. 2
Office Address 970 Fourth Financial Center, Wichita, KS 67202
Character of Well (Completed as Oil, Gas or Dry Hole) dry hole
Date Well completed 12/31/81 19
Application for plugging filed 12/31/81 19
Application for plugging approved 12/31/81 19
Plugging commenced 12/31/81 19
Plugging completed 12/31/81 19
Reason for abandonment of well or producing formation dry hole

If a producing well is abandoned, date of last production 19

Was permission obtained from the Conservation Division or its agents before plugging was commenced? yes

Name of Conservation Agent who supervised plugging of this well Clarence Thomas
Producing formation Depth to top Bottom Total Depth of Well 5662'
Show depth and thickness of all water, oil and gas formations.

OIL, GAS OR WATER RECORDS

CASING RECORD

FORMATION	CONTENT	FROM	TO	SIZE	PUT IN	PULLED OUT

Describe in detail the manner in which the well was plugged, indicating where the mud fluid was placed and the method or methods used in introducing it into the hold. If cement or other plugs were used, state the character of same and depth placed, from feet to feet for each plug set.

Hole plugged with 60-40 pozmix, 2% gell, 3% CC as follows:
60 sacks @890', 25 sacks @ 400', 10 sacks @ 40',
5 sacks in rathole. Plugging completed at 8 PM, December 31, 1980.

RECEIVED
Conservation Commission

MAR 13 1981

CONSERVATION DIVISION
Wichita, Kansas

(If additional description is necessary, use BACK of this sheet)

Name of Plugging Contractor BEREDCO INC.

STATE OF Kansas COUNTY OF Sedgwick
J. D. Marcus (employee of owner) or (owner or operator)
of the above-described well, being first duly sworn on oath, says: That I have knowledge of the facts, statements, and matters herein contained and the log of the above-described well as filed and that the same are true and correct. So help me God.

(Signature) [Signature]
970 Fourth Financial Center, Wichita, KS 67202
(Address)

SUBSCRIBED AND SWORN TO before me this 10th day of March, 19 81



My commission expires 4/27/81

[Signature]
Notary Public.

DRILLERS LOG

RANDALL #2
Clark, County
NW SW NE
Sec. 24-34S-22W

Company: Beren Corporation

Contractor: BEREDCO INC.

Comm: December 15, 1980

Comp.: December 31, 1980

Casing: 8 5/8", 24# set at 868' with 475 sacks pozmix, 2% gel, 3% CC, 60-40 dry hole

<u>FORMATION</u>	<u>FROM</u>	<u>TO</u>
Sand	0'	43'
RB & Shale	43'	872'
Red Bed	872'	1124'
Shale	1124'	1775'
Lime & Shale	1775'	5200'
Lime	5200'	5253'
Lime & Shale	5253'	5549'
Lime	5249'	5560'
Lime & Shale	5560'	5600'
Lime	5600'	5636'
Lime & Shale	5636'	5650'
Lime	5650'	5662'

Rotary Total Depth 5662'

STATE OF KANSAS

ss:

COUNTY OF SEDGWICK

I certify that this is a true and correct copy of the above log as shown by the drilling reports.

BEREDCO

[Handwritten Signature]

RECEIVED
STATE CONSERVATION COMMISSION

MAR 13 1981

Subscribed and sworn to before me this 10 day of March, 1980

CONSERVATION DIVISION
Wichita, Kansas



[Handwritten Signature]