


STATE OF KANSAS
STATE CORPORATION COMMISSION

WELL PLUGGING RECORD

Give All Information Completely
Make Required Affidavit
Mail or Deliver Report to
Conservation Division
State Corporation Comm.
245 North Water
Wichita, KS 67202

Clark County. Sec. 16 Twp. 34S Rge. 22 E/W
Location as "NE/CNW $\frac{1}{4}$ SW $\frac{1}{4}$ " or footage from lines
C NE NE

Lease Owner Cameron Funk
Lease Name Rankin Well No. #1
Office Address 416 Union Center, Wichita, Kans. 67202
Character of Well (Completed as Oil, Gas or Dry Hole)
Dry Hole

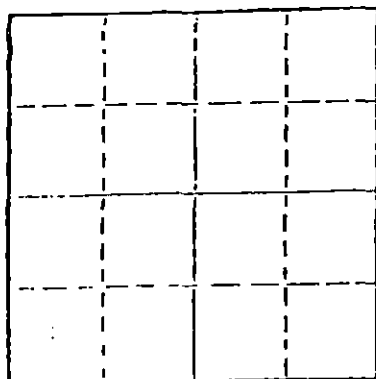

Locate well correctly on above
Section Plat

Date Well completed 9-6-76 19
Application for plugging filed 9-6-76 19
Application for plugging approved 9-6-76 19
Plugging commenced 9-6-76 19
Plugging completed 9-6-76 19
Reason for abandonment of well or producing formation
Commercial quantities of oil not found
If a producing well is abandoned, date of last production 19

Was permission obtained from the Conservation Division or
its agents before plugging was commenced? Yes

Name of Conservation Agent who supervised plugging of this well Clarence Thomas
Producing formation _____ Depth to top _____ Bottom _____ Total Depth of Well 5545'
Show depth and thickness of all water, oil and gas formations.

OIL, GAS OR WATER RECORDS

CASING RECORD

FORMATION	CONTENT	FROM	TO	SIZE	PUT IN	PULLED OUT
				8 5/8"	612'	none

Describe in detail the manner in which the well was plugged, indicating where the mud fluid
was placed and the method or methods used in introducing it into the hold. If cement or other
plugs were used, state the character of same and depth placed, from _____ feet to
_____ feet for each plug set.

Plug @ 900' w/50 sx.
Plug @ 600' w/35 sx.
Plug @ 40' w/15 sx.
5 sx. rathole

RECEIVED
STATE CORPORATION COMMISSION
OCT 06 1976

CONSERVATION DIVISION
Wichita, Kansas

(If additional description is necessary, use BACK of this sheet)

Name of Plugging Contractor Rains & Williamson Oil Co., Inc.

STATE OF Kansas COUNTY OF Sedgwick, ss.
Wilson Rains, President of Rains & Williamson Oil Co., Inc. (owner or operator)
of the above-described well, being first duly sworn on oath, says: That I have knowledge of
the facts, statements, and matters herein contained and the log of the above-described well
as filed and that the same are true and correct. So help me God.

(Signature)

435 Page Court, 220 W. Douglas, Wichita
Ks.
(Address)

SUBSCRIBED AND SWORN TO before me this 13 day of September, 1976




Juanita M. Green
Notary Public.

WELL LOG

COMPANY Cameron Funk
 FARM Rankin NO. #1
 RIG. NO. #3
 TOTAL DEPTH 5545'
 COMM. 8-22-76 COMP. 9-6-76
 CONTRACTOR Rains & Williamson Oil Co., Inc.

SEC. 16 T. 34S R. 22W
 LOC. C NE NE

COUNTY Clark
 KANSAS

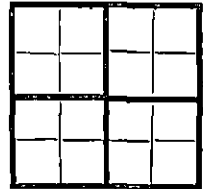

20" @ 92' ^{DABING} w/300 sx.

15 8 5/8" @ 612' w/300 sx. 50/50 pos.
 12 6 3% cc, 2% gel.
 13 5

ELEVATION

PRODUCTION D&A

FIGURES INDICATE BOTTOM OF FORMATIONS

Sand & Redbed	570
Redbed	1075
Redbed & Shale	1339
Shale	1926
Shale & Lime	2517
Lime & Shale	2816
Shale & Lime	2951
Lime & Shale	3828
Shale & Lime	3944
Lime & Shale	4110
Shale & Lime	4404
Lime & Shale	5212
Lime	5306
Lime & Shale	5545
<u>Rotary Total Depth</u>	<u>5545</u>

RECEIVED
 STATE CORPORATION COMMISSION
 OCT 06 1976
 CONSERVATION DIVISION
 Wichita, Kansas

State of Kansas
 County of Sedgwick } ss:

I, Wilson Rains, President of the Rains & Williamson Oil Co., Inc.

upon oath state that the above and foregoing is a true and correct copy of the log of the Rankin #1 well.

Wilson Rains
 Wilson Rains



Juanita M. Green
 NOTARY PUBLIC
 Juanita M. Green