

STATE OF KANSAS
STATE CORPORATION COMMISSION

Form CP-4

Give All Information Completely
Make Required Affidavit
Mail or Deliver Report to:
Conservation Division
State Corporation Commission
212 No. Market
Wichita, Kansas

WELL PLUGGING RECORD

Clark County, Sec. 16 Twp. 34S Rge. 22W (E) (W)

Location as "NE/CNW/SW" or footage from lines C SE/4
Lease Owner Woods Petroleum Corporation

Lease Name Broadie Well No. 1

Office Address P. O. Box 18667, Oklahoma City, Oklahoma.

Character of Well (completed as Oil, Gas or Dry Hole) dry hole

Date well completed 4-22 1971

Application for plugging filed (Verbal) 4-21 1971

Application for plugging approved (Verbal) 4-21 1971


Plugging commenced 4-21 1971

Plugging completed 4-22 1971

Reason for abandonment of well or producing formation dry hole

If a producing well is abandoned, date of last production - 19 -

Was permission obtained from the Conservation Division or its agents before plugging was commenced? Yes

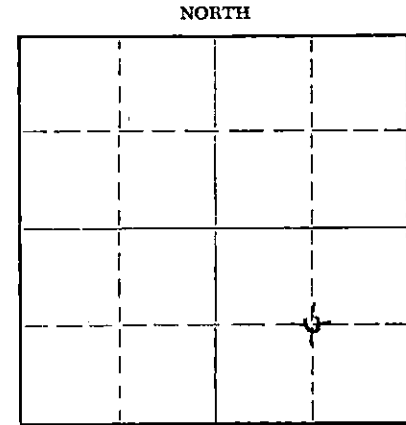

Locate well correctly on above Section Plat

Name of Conservation Agent who supervised plugging of this well Edgar J. Eves, Sublette, Kansas

Producing formation - Depth to top - Bottom - Total Depth of Well 5608 Feet

Show depth and thickness of all water, oil and gas formations.

OIL, GAS OR WATER RECORDS

CASING RECORD

FORMATION	CONTENT	FROM	TO	SIZE	PUT IN	PULLED OUT
Lansing	Nonporous	4427	4510	8-5/8"	621'	-
Morrow	Nonporous	5356	5450			
Mississippi Chester	Nonporous	5450	5608			

Describe in detail the manner in which the well was plugged, indicating where the mud fluid was placed and the method or methods used in introducing it into the hole. If cement or other plugs were used, state the character of same and depth placed, from feet to feet for each plug set.

Filled hole with drilling mud, spotted 35 sacks cement from 635' to 535', filled with mud, spotted 15 sacks from 45' to surface. Welded on cap.

RECEIVED
STATE CORPORATION COMMISSION
APR 30 1971
CONSERVATION DIVISION
Wichita, Kansas

(If additional description is necessary, use BACK of this sheet)
Name of Plugging Contractor Rine Drilling Company
Address 300 West Douglas, Suite 600, Wichita, Kansas, 67202

STATE OF Oklahoma, COUNTY OF Oklahoma, ss.
Lee Powell (employee of owner) or (owner) of the above-described well, being first duly sworn on oath, says: That I have knowledge of the facts, statements, and matters herein contained and the log of the above-described well as filed and that the same are true and correct. So help me God.

(Signature) [Signature]
P. O. Box 18667, Oklahoma City, Oklahoma, 73118.
(Address)

SUBSCRIBED AND SWORN to before me this 27 day of April, 1971

My commission expires 3-8-74

Jane LaRue Whitfield
Notary Public.

KANSAS GEOLOGICAL SOCIETY
KANSAS WELL LOG BUREAU - KANSAS WELL SAMPLE BUREAU
KANSAS GEOLOGICAL SOCIETY BUILDING
508 EAST MURDOCK - WICHITA, KANSAS

COMPANY **Woods Petroleum Corporation**

SEC. **16** T. **34S** R. **22W**
LOC. **C SE/4**

FARM **Broadie** NO. **1**

COUNTY **Clark**

TOTAL DEPTH **5608'**

COMM. **4-8-71**

COMP. **4-22-71**

SHOT OR TREATED **--**

CONTRACTOR **Rine Drilling Company**

ISSUED

KANSAS		

CASING

20	10
15	5/8" @ 621' w/325 sacks.
12	6
13	5

ELEVATION **1847' DF**

1837' GL

PRODUCTION

FIGURES INDICATE BOTTOM OF FORMATIONS

0-700'	Clay, shale & sand.
700-885'	Shale and red beds.
885-1200'	Red beds and anhy.
1200-1400'	Shale.
1400-2400'	Anhy.
2400-3300'	Shale with lime and sand streaks.
3300-3450'	Lime and shale.
3450-3675'	Shale.
3675-3800'	Sand.
3800-4200'	Shale.
4200-4260'	Lime and sand.
4260-4320'	Shale.
4320-4370'	Lime and sand.
4370-4427'	Shale
4427-5010'	Lansing-Kansas City Lime with shale streaks.
5010-5106'	Shale with lime streaks.
5106-5220'	Marmaton Lime with shale streaks.
5220-5356'	Cherokee Shale with Lime streaks.
5356-5450'	Morrow shale with sand and lime streaks.
5450-TD	Mississippi Chester Lime with shale streaks.
DTD. - 5608'	
LTD - 5612'	

RECEIVED
STATE CORPORATION COMMISSION
APR 30 1971
CONSERVATION DIVISION
Wichita, Kansas