

STATE OF KANSAS  
STATE CORPORATION COMMISSION


WELL PLUGGING RECORD

Give All Information Completely  
Make Required Affidavit  
Mail or Deliver Report to:  
Conservation Division  
State Corporation Commission  
211 No. Broadway  
Wichita, Kansas

Morton County. Sec. 23 Twp. 33S Rge. 42 ( W) ( W)

Location as "NE/CNW/SW" or footage from lines. Ctr SE NE  
Lease Owner Cities Service Oil Co.  
Lease Name Federal Farm "B" Well No. 1  
Office Address Bartlesville, Oklahoma  
Character of Well (completed as Oil, Gas or Dry Hole) Dry Hole  
Date well completed May 9 19 60  
Application for plugging filed May 9 19 60  
Application for plugging approved May 10 19 60  
Plugging commenced May 10 19 60  
Plugging completed May 15 19 60  
Reason for abandonment of well or producing formation Dry Hole

NORTH

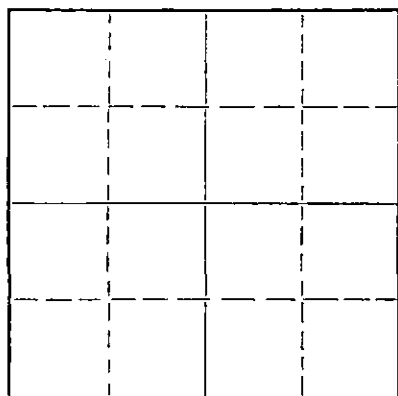

Locate well correctly on above  
Section Plat

If a producing well is abandoned, date of last production \_\_\_\_\_ 19\_\_\_\_  
Was permission obtained from the Conservation Division or its agents before plugging was commenced? yes

Name of Conservation Agent who supervised plugging of this well Frank Broadfoot  
Producing formation \_\_\_\_\_ Depth to top \_\_\_\_\_ Bottom \_\_\_\_\_ Total Depth of Well \_\_\_\_\_ Feet  
Show depth and thickness of all water, oil and gas formations.

OIL, GAS OR WATER RECORDS

CASING RECORD

FORMATION	CONTENT	FROM	TO	SIZE	PUT IN	PULLED OUT
<u>Chester</u>	<u>Dry</u>	<u>5010</u>	<u>5020</u>	<u>8-5/8"</u>	<u>1417'</u>	<u>None</u>
<u>Keyes</u>	<u>Dry</u>	<u>4918'</u>	<u>4948</u>	<u>5-1/2</u>	<u>5059'</u>	<u>2902'</u>

Describe in detail the manner in which the well was plugged, indicating where the mud fluid was placed and the method or methods used in introducing it into the hole. If cement or other plugs were used, state the character of same and depth placed, from \_\_\_\_\_ feet to \_\_\_\_\_ feet for each plug set.

Spotted 50 sacks of cement on bottom to 4810' filled with heavy rotary mud to 1408'  
spotted 20 sacks cement at 1408' filled with heavy rotary mud to 403', spotted 10  
sacks of cement @ 403', filled with heavy rotary mud to 40', filled to surface with  
10 sacks of cement

RECEIVED  
STATE CORPORATION COMMISSION  
MAY 27 1960  
CONSERVATION DIVISION  
Wichita, Kansas

(If additional description is necessary, use BACK of this sheet)

Name of Plugging Contractor Daco Lease & Well Service  
Address 1700 South Main, Borger, Texas

STATE OF Kansas, COUNTY OF Seward, ss.  
H. V. Anderson, Div. Supt. (employee of owner) or (owner or operator) of the above-described well, being first duly sworn on oath, says: That I have knowledge of the facts, statements, and matters herein contained and the log of the above-described well as filed and that the same are true and correct. So help me God.

(Signature) H. V. Anderson H. V. Anderson  
Box 70, Liberal, Kansas (Address)

SUBSCRIBED AND SWORN TO before me this 19 day of May, 19 60

My commission expires 4-23-64

Evelyn Ray  
Evelyn Ray Notary Public.



KANSAS  
STATE CORPORATION COMMISSION

CONSERVATION DIVISION AGENT'S REPORT

TO:  
Jewel M. Ogden, Director  
500 Insurance Building  
212 North Market  
Wichita 2, Kansas

File No. \_\_\_\_\_ County: MORTON

Location: CSE-NE Sec. 23 Twp. 33 Rge. 42 (E) (W)

Name of Field: \_\_\_\_\_ Total Depth: 5060'

I have this date completed supervision of plugging of:

Lease Name: FEDERAL FARM 'B' Well No. 1

Operator's Full Name: CITIES SERVICE OIL CO

Complete Address: BARTELSVILLE, OKLA

Plugging Contractor: DACO LEASE + WELL SERVICE

Address: 1700 S. MAIN BOGERT, TEX License No. \_\_\_\_\_

Oil Well \_\_\_\_\_ Gas Well  Input Well \_\_\_\_\_ SWD Well \_\_\_\_\_ D & A \_\_\_\_\_

Other well as hereafter indicated: \_\_\_\_\_

Was any delay in plugging operations caused by Conservation Division Agent? Yes \_\_\_\_\_ No

If yes how long? \_\_\_\_\_ Reason: \_\_\_\_\_

Operation Completed: Hour 10<sup>AM</sup> Day 15 Month MAY Year 1960

The above well was plugged as follows:

8 7/8 - 1415' - 5 1/4 - 5059' - TOP PERF 4-9-18  
SANDS BOTTOM OF HOLE BACK TO 4810'  
SPOTTED 50 SV CMT - FILLED W/ MUD TO  
1400' - SPOTTED 20 SV CMT - FILLED W/ MUD  
TO 400' - W/ 10 SV CMT PLUG - MUDDED  
TO 40' - FILLED TO BASE OF COLLAR W/ 10  
SV CMT.

RECEIVED  
STATE CORPORATION COMMISSION

MAY 27 1960

CONSERVATION DIVISION  
Wichita, Kansas

Signed: Frank Brundage  
Conservation Division Agent

Reviewed: J. Lewis Brock  
Field Supervisor

Remarks:

INVOICED

DATE 6/2/60

INV. NO. 1452-W