

STATE OF KANSAS
STATE CORPORATION COMMISSION

WELL PLUGGING RECORD

Give All Information Completely
Make Required Affidavit
Mail or Deliver Report to:
Conservation Division
State Corporation Commission
800 Bitting Building
Wichita, Kansas

Morton

County. Sec. 24 Twp. 33 Rge. 42W (E) (W)

Location as "NE/CNW/SW" or footage from lines 660'S & 660'W of N-1/4 Cor.

Lease Owner Terminal Facilities, Inc.

Lease Name Minor "A" #1 Well No.

Office Address Bartlesville, Oklahoma

Character of Well (completed as Oil, Gas or Dry Hole) Dry-Hole

Date well completed 10-23-1953 19

Application for plugging filed 10-24-1953 19

Application for plugging approved 10-26-1953 19


Plugging commenced 10-27-1953 19

Plugging completed 10-28-1953 19

Reason for abandonment of well or producing formation DRY HOLE

If a producing well is abandoned, date of last production 19

Was permission obtained from the Conservation Division or its agents before plugging was commenced? Yes

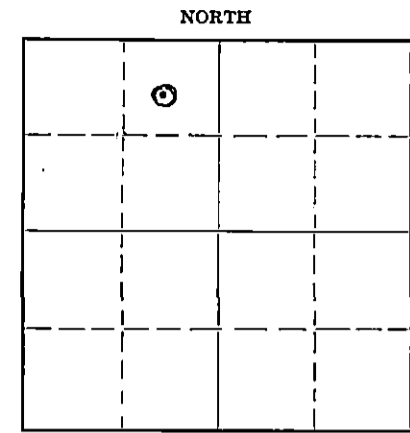

Locate well correctly on above Section Flat

Name of Conservation Agent who supervised plugging of this well R. J. Phillipe

Producing formation Depth to top Bottom Total Depth of Well 3550' Feet

Show depth and thickness of all water, oil and gas formations.

OIL, GAS OR WATER RECORDS

CASING RECORD

Formation	Content	From	To	Size	Put In	Pulled Out
				8-5/8	600	None

Describe in detail the manner in which the well was plugged, indicating where the mud fluid was placed and the method or methods used in introducing it into the hole. If cement or other plugs were used, state the character of same and depth placed, from feet to feet for each plug set.

Spot 170 sacks of cement on bottom from 3550 to 3000'; Heavy rotary mud to 630'; 20-sacks of cement to 575'; Heavy rotary mud to 30'; 10-sacks of cement to 4' of surface at which point the casing was cut off and a steel cap was welded on.

RECEIVED

STATE CORPORATION COMMISSION

OCT 30 1953

CONSERVATION DIVISION

Wichita, Kansas

(If additional description is necessary, use BACK of this sheet)

Correspondence regarding this well should be addressed to H.V. Anderson
Address Box 70, Liberal, Kansas

STATE OF Kansas, COUNTY OF Seward, ss.

H.V. Anderson (employee of owner) or (owner or operator) of the above-described well, being first duly sworn on oath, says: That I have knowledge of the facts, statements, and matters herein contained and the log of the above-described well as filed and that the same are true and correct. So help me God.

(Signature) H.V. Anderson

Box 70, Liberal, Kansas (Address)

SUBSCRIBED AND SWORN to before me this 29th day of October, 19 53

My commission expires 5-23-1957

J. Maloney Notary Public

PLUGGING
FILE SEC 24 T 33 R 42W
BOOK PAGE 138 LINE 8