


STATE OF KANSAS
STATE CORPORATION COMMISSION

Form CP-4

Give All Information Completely
Make Required Affidavit
Mail or Deliver Report to:

Conservation Division
State Corporation Commission
P. O. Box 17027
Wichita, Kansas 67217
NORTH

WELL PLUGGING RECORD

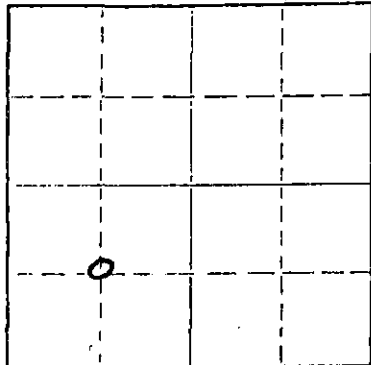

Locate well correctly on above
Section Plat

Morton County, Sec. 24 Twp. 33 Rge. 12 (E) (W) X
Location as "NE/CNW/SW" or footage from lines C SW/4
Lease Owner Edgar W. White and Associates
Lease Name Minor "A" Well No. 1
Office Address Drawer O, Elkhart, Kansas 67950
Character of Well (completed as Oil, Gas or Dry Hole)
Date well completed 7-20 1961
Application for plugging filed 8-27 1975
Application for plugging approved 8-29 1975
Plugging commenced 9-3 1975
Plugging completed 9-4 1975
Reason for abandonment of well or producing formation water logged

If a producing well is abandoned, date of last production Jan. 1975
Was permission obtained from the Conservation Division or its agents before plugging was commenced? Yes

Name of Conservation Agent who supervised plugging of this well Clarence Thomas
Producing formation Topeka Depth to top. Bottom. Total Depth of Well 3427
Show depth and thickness of all water, oil and gas formations.

OIL, GAS OR WATER RECORDS

CASING RECORD

FORMATION	CONTENT	FROM	TO	SIZE	PUT IN	PULLED OUT
				8 5/8	642	none
				4 1/2	3425	1230

Describe in detail the manner in which the well was plugged, indicating where the mud fluid was placed and the method or methods used in introducing it into the hole. If cement or other plugs were used, state the character of same and depth placed, from feet to feet for each plug set.

Pump 10 sks. of cement to 3050
Pump 50 sks. of cement @ 700 to 600
Put 10 sks. of cement @ 45 to 0

RECEIVED
STATE CORPORATION COMMISSION

OCT 1 1975

CONSERVATION DIVISION
Wichita, Kansas

(If additional description is necessary, use BACK of this sheet)
Name of Plugging Contractor Sargents Casing Pulling Service Kansas No. 511
Address Box 506 Liberal, Kansas 67901

STATE OF Kansas COUNTY OF Morton ss.
Edgar W. White (employee of owner) or (owner or operator) of the above-described well, being first duly sworn on oath, says: That I have knowledge of the facts, statements, and matters herein contained and the log of the above-described well as filed and that the same are true and correct. So help me God.

(Signature) Edgar W. White
Elkhart Kans 67950 (Address)

SUBSCRIBED AND SWORN TO before me this 18th day of September, 1975

My commission expires March 22, 1978 Allen C. Brown Notary Public.

ROTARY DRILLING LOG

OPERATOR: Anadarko Production Company
Minor "A" #1
C SW/4 Sec. 24-33-42W,
Morton County, Kansas

CONTRACTOR: Capitt Drilling, Inc.
COMM: 7-10-61
COMP: 7-20-61

Remarks: Set 8-5/8" surface casing
at 642' G.L. cemented with
300 sx. Poz., 100 sx. Com.
w/2% C.C.

FORMATIONS:

Surface Soil & Clay	124'
Sand & Shale	215'
Shale	300'
Shale & Red Bed	532'
Red Bed	642'
Shale & Sand	965'
Shale & Shells	1342'
Red Bed & Shale	1423'
Anhydrite	1446'
Red Bed & Shale	1530'
Shale	1800'
Shale & Lime	2215'
Lime & Shale	2800'
Shale & Lime	2905'
Lime & Shale	3070'
Shale & Lime	3153'
Lime & Shale	3427'
Rotary Total Depth	3427'

Set 4-1/2" casing at 3425' cemented
with 150 sx. common with 4% Gel, 25#
Gilsonite per sx.

We certify the above log is true and
correct to the best of our knowledge
and belief.

CAPITT DRILLING, INC.

R.R. McNicol

R. R. McNicol

RECEIVED
STATE CORPORATION COMMISSION

AUG 28 1975

CONSERVATION DIVISION
Wichita, Kansas

[Faint, illegible handwritten notes and stamps on the left side of the page]