


STATE OF KANSAS
STATE CORPORATION COMMISSION

Give All Information Completely
Make Required Affidavit
Mail or Deliver Report to:
Conservation Division
State Corporation Commission
800 Bittling Building
Wichita, Kansas

15-175-00069-00-00

WELL PLUGGING RECORD

NORTH

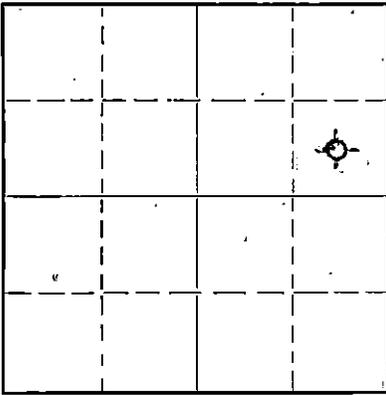

Locate well correctly on above
Section Flat

Seward CO. Kansas County. Sec. 23 Twp. 34 Rge. 32 (E) (West)
Location as "NE/CNW/SW" or footage from lines C SE NE 1/4
Lease Owner Mid-Continent Petroleum Corporation
Lease Name Price Davies Well No. 1
Office Address 512 Orpheum Bldg. Wichita, Kansas
Character of Well (completed as Oil, Gas or Dry Hole) Dry Hole
Date well completed 4-7-54 19
Application for plugging filed 4-7-54 19
Application for plugging approved 4-7-54 Telephone M. A. Rizes Pratt 9Ks
Plugging commenced 4-7-54 19
Plugging completed 4-7-54 19
Reason for abandonment of well or producing formation Dry Hole

If a producing well is abandoned, date of last production 19
Was permission obtained from the Conservation Division or its agents before plugging was commenced? Yes

Name of Conservation Agent who supervised plugging of this well M. A. Rizes Pratt, Kansas
Producing formation None Depth to top Bottom Total Depth of Well 6250' Feet
Show depth and thickness of all water, oil and gas formations.

OIL, GAS OR WATER RECORDS

CASING RECORD

Formation	Content	From	To	Size	Put In	Pulled Out
Sand w/shale breaks.	Water	390	630	13 3/8	679'	None
No oil Nor gas sds.				9 5/8	2634'	None

Describe in detail the manner in which the well was plugged, indicating where the mud fluid was placed and the method or methods used in introducing it into the hole. If cement or other plugs were used, state the character of same and depth placed, from feet to feet for each plug set.

Plugged with heavy drill mud from 6250' to 450' From top. Set Halliburton plug with cotton seed hulls in sack on top of plug. Cemented with 35 sacks cement. Filled with mud from top of cement to 35' from top of hole. Set Halliburton plug anchored with wire. Put hulls on top of plug. Cemented with 15 sacks cement to top of casing in cellar. Cellar to be filled to ground level with dirt.

RECEIVED
STATE CORPORATION COMMISSION

APR 23 1954 4-23-54

CONSERVATION DIVISION
Wichita, Kansas

(If additional description is necessary, use BACK of this sheet)

Correspondence regarding this well should be addressed to R. L. Mankey
Address 512 Orpheum Bldg. Wichita, Kansas

STATE OF Kansas COUNTY OF Barton ss.

(employee of owner) or (owner or operator) of the above-described well, being first duly sworn on oath, says: That I have knowledge of the facts, statements and matters herein contained and the log of the above-described well as filed and that the same are true and correct. So help me God.

(Signature)

R. L. Mankey
Ellenwood Kansas
Agent

(Address)

SUBSCRIBED AND SWORN to before me this 1 day of July, 1956

Notary Public

My commission expires July 1 - 1956

22-5133-s 9-48-10M

PLUGGING
FILE SEC 23 T 34 R 32W
BOOK PAGE 25 LINE 16

15-175-00069-00-00

Price Davies - 5, Well No. 1
NE/4 Section 23-34S-32W
Seward County, Kansas
Mid-Continent Petroleum Corporation

CASING RECORD

Set 13 3/8" csg. @ 695' w/ 700 sax
Set 9 5/8" csg. @ 2648' w/ 800 sax

COMMENCED: 3-9-54
COMPLETED: 4-7-54
RESULT: D & A

Sand and shells	0	123
Sand and shale	123	646
Red Bed	646	993
Red Bed and shale	993	1600
Sandy shale & Anhydrite	1600	1819
Shale & Anhydrite	1819	1974
Shale, Anhydrite and salt	1974	2093
Shale & Anhydrite	2093	2100
Shale, Anhydrite & shale	2100	2380
Shale & Anhydrite	2380	2517
Shale & lime	2517	2593
Anhydrite & Lime	2593	2648
Lime	2648	2829
Lime & shale	2829	3032
Sandy lime & shale	3032	3071
Lime & shale	3071	3943
Shale & lime streaks	3943	4074
Shale, lime & shells	4074	4171
Lime & shale	4171	4788
Cherty lime	4788	4809
Lime, shale, some chert	4809	4831
Lime	4831	4923
Lime & shale	4923	5341
Lime	5341	5357
Lime & shale	5357	5913
Shale	5913	5918
Shale & sandy lime	5918	5960
Shale (sandy)	5960	6000
Shale & sandy lime	6000	6077
Shale & lime	6077	6216
Lime	6216	6235
Shale & lime	6235	6250
TOTAL DEPTH	6250	

RECEIVED
STATE CORPORATION COMMISSION
APR 23 1954
CONSERVATION DIVISION
Wichita, Kansas

PLUGGING
WELL NO. 23-34S-32W
PAGE 25 LINE 16