

STATE OF KANSAS
STATE CORPORATION COMMISSION


15-175-20551-00-00

WELL PLUGGING RECORD

Give All Information Completely
Make Required Affidavit
Mail or Deliver Report to
Conservation Division
State Corporation Comm.
245 North Water
Wichita, KS 67202

Seward County. Sec. 25 Twp. 34S Rge. 32W E/W
Location as "NE/CNW $\frac{1}{4}$ SW $\frac{1}{4}$ " or footage from lines _____

C SE
Lease Owner Tucker Production Corporation
Lease Name DAVIES Well No. 1
Office Address 2546 W. Main, Littleton, Co. 80120
Character of Well (Completed as Oil, Gas or Dry Hole) _____

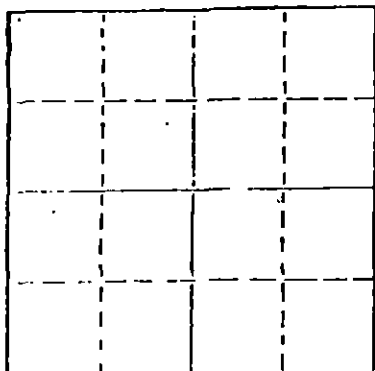

Locate well correctly on above
Section Plot

Dry Hole
Date Well completed July 19 1981
Application for plugging filed _____ 19____
Application for plugging approved _____ 19____
Plugging commenced July 19 1981
Plugging completed July 19 1981
Reason for abandonment of well or producing formation _____

Dry Hole
If a producing well is abandoned, date of last production _____ 19____

Was permission obtained from the Conservation Division or its agents before plugging was commenced? _____

Name of Conservation Agent who supervised plugging of this well Clarence Thomas, Jr., Grd Ct
Producing formation _____ Depth to top _____ Bottom _____ Total Depth of Well 6470'
Show depth and thickness of all water, oil and gas formations.

OIL, GAS OR WATER RECORDS

CASING RECORD

FORMATION	CONTENT	FROM	TO	SIZE	PUT IN	PULLED OUT
	Surface	0	1533'	8-5/8"	1533'	None
	Casing					

Describe in detail the manner in which the well was plugged, indicating where the mud fluid was placed and the method or methods used in introducing it into the hold. If cement or other plugs were used, state the character of same and depth placed, from _____ feet to _____ feet for each plug set.

Plugged Hole w/50 sax cement @ 1500'
/25 sax cement @ 750'
/10 sax cement @ 40'
/5 sax cement in rat hole, &
/5 sax cement in mouse hole.

Job completed @ 7 P.M.

RECEIVED

(If additional description is necessary, use BACK of STATE CORPORATION COMMISSION

Name of Plugging Contractor Halliburton

AUG 12 1981

STATE OF KANSAS COUNTY OF SEDGWICK CONSERVATION DIVISION

John R. Bartholomew of Sage Drilling Co. being first duly sworn on oath, says: That I have knowledge of the facts, statements, and matters herein contained and the log of the above-described well as filed and that the same are true and correct. So help me God.

(Signature) John R. Bartholomew
222 Sutton Place, Wichita, Ks. 67202
(Address)

SUBSCRIBED AND SWORN TO before me this 31st day of July, 19 81

Louise K. Whitted
Notary Public.

My commission expires _____



15-175-20551-00-00

DRILLERS LOG

DAVIES NO. 1

CASING RECORD:	OPERATOR:	Tucker Production Corp.	DESCRIPTION:
8-5/8" set @ 1533' w/750 sax cement	CONTRACTOR:	Sage Drilling Co., Inc.	C SE
TOTAL DEPTH:	COMMENCED:	July 7, 1981	Sec. 25-34S-32W
6470'	COMPLETED:	July 19, 1981	Seward County, Kansas


<u>FORMATION</u>	<u>FROM</u>	<u>TO</u>	<u>REMARKS</u>
Sand & Red Bed	0	1540	
Anhydrite & Red Bed	1540	2160	
Lime & Shale	2160	2637	
Shale & Lime	2637	2995	
Lime & Shale	2995	3616	
Shale & Lime	3616	3785	
Lime & Shale	3785	6470	Logged Hole. Ran DST#1, DST#2, DST#3. D & A.

I certify that this is a true and correct copy of the log on the above captioned well to the best of my knowledge.

SAGE DRILLING CO., INC.

By John R. Bartholomew
John R. Bartholomew

Subscribed and sworn to before me this 31st day of July, 1981.

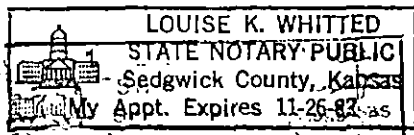

Louise K. Whitted
Louise K. Whitted, Notary Public

RECEIVED
STATE CORPORATION COMMISSION

AUG 12 1981
CONSERVATION DIVISION
Wichita, Kansas