


STATE OF KANSAS
STATE CORPORATION COMMISSION

Give All Information Completely
Make Required Affidavit
Mail or Deliver Report to:
Conservation Division
State Corporation Commission
211 No. Broadway
Wichita, Kansas

15-175-10000-00-00

WELL PLUGGING RECORD

NORTH

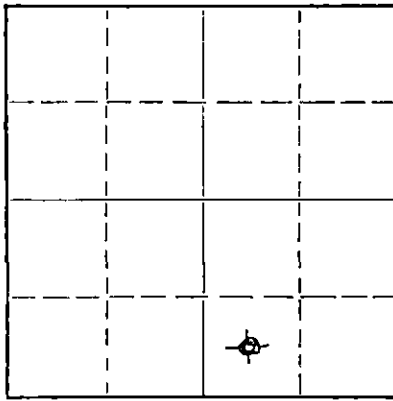

Locate well correctly on above
Section Plat

Seward County. Sec. 27 Twp. 34S Rge. 32 (E) W (W)
Location as "NE/CNW/SW" or footage from lines C SW 1/4 SE 1/4
Lease Owner Ambassador Oil Corporation
Lease Name A. J. Lancaster Well No. 1
Office Address 304 Hightower Building, Oklahoma City, Oklahoma
Character of Well (completed as Oil, Gas or Dry Hole) dry hole
Date well completed January 3, 1961
Application for plugging filed April 13, 1961
Application for plugging approved April 14, 1961
Plugging commenced April 18, 1961
Plugging completed April 23, 1961
Reason for abandonment of well or producing formation Well failed to produce commercial quantities of gas
If a producing well is abandoned, date of last production -- 1961
Was permission obtained from the Conservation Division or its agents before plugging was commenced? yes

Name of Conservation Agent who supervised plugging of this well Mr. W. J. Lackamp
Producing formation Lower & Upper Morrow Depth to top 5986 Bottom 6006 Total Depth of Well 6170 Feet
Show depth and thickness of all water, oil and gas formations.

OIL, GAS OR WATER RECORDS

CASING RECORD

FORMATION	CONTENT	FROM	TO	SIZE	PUT IN	PULLED OUT
Chester	Gas	6120'	6126'	8-5/8"	1610'	left in hole
Chester		6140'	6154 1/2'	4-1/2"	6169'	3308'
Lower Morrow	Gas	5986'	6006'			
Upper Morrow	Gas	5848'	5862'			
Upper Morrow	Gas	5868'	5872'			

Describe in detail the manner in which the well was plugged, indicating where the mud fluid was placed and the method or methods used in introducing it into the hole. If cement or other plugs were used, state the character of same and depth placed, from _____ feet to _____ feet for each plug set.

Cast iron bridge plug set at 6052'. Filled hole with heavy mud. Baker Model "D" Production packer @ 5955'. Spotted 20 sx. cement plug from 5684-5925; 48 sx cement plug from 1310' - 1600'. 20 sx. cement plug from 310'-600', 8 sx. cement in top of 8-5/8" surface casing. Welded steel plate on top of 8-5/8" casing.

RECEIVED
STATE CORPORATION COMMISSION
APR 26 1961
CONSERVATION DIVISION
Wichita, Kansas

(If additional description is necessary, use BACK of this sheet)

Name of Plugging Contractor Smith & Smith (License #205)
Address Box 8, Cushing, Oklahoma

STATE OF Oklahoma, COUNTY OF Oklahoma, ss.
Harold E. Burke (employee of owner) or (owner or operator) of the above-described well, being first duly sworn on oath, says: That I have knowledge of the facts, statements, and matters herein contained and the log of the above-described well as filed and that the same are true and correct. So help me God.

(Signature) Harold E. Burke
Harold E. Burke, District Prod. Supt.
304 Hightower Building, Oklahoma City, Okla.
(Address)

SUBSCRIBED AND SWORN TO before me this 25th day of April, 1961

Peggy J. Southern
Notary Public.

My commission expires June 2, 1964



15-175-10000-00-00

WELL LOG

COMPANY **AMBASSADOR OIL CORPORATION**

SEC 27 T 34S R 32W

FARM **LANCASTER** NO. 1

LOC. **C-SW, 8E**

TOTAL DEPTH **6170'**

COUNTY **SEWARD CO., KANSAS**

COMM. **September 30, 1960** COMP. **October 27, 1960**

CONTRACTOR **GARVEY DRILLING COMPANY**



LOGGING **8 5/8" @ 1610' w/350 sax.**
4 1/2" @ 6169' w/250 sax.

ELEVATION **2747' KB**

PRODUCTION

FIGURES INDICATE BOTTOM OF FORMATIONS

640	Surface clay & sand
778	Red bed
1130	Red bed w/sand streaks
1190	Sand
1450	Red bed & shells
1610	Red bed, shale & shells
1650	Gyp rock & shale
2100	Shale & shells
2300	Lime & shale
2320	Shale & lime
2320	Shale & lime
3675	Lime & shale
3745	Lime & shale w/chalk streaks
4925	Lime & shale
5015	Lime
5325	Lime & shale
5360	Lime
5675	Lime & shale
5900	Shale
6025	Shale & sand
6070	Shale & lime
6125	Lime & shale
6170	Lime
6170	T. D.

RECEIVED
STATE CORPORATION COMMISSION

APR 14 1961

CONSERVATION DIVISION
Wichita, Kansas

State of **KANSAS**

County of **BARTON**

I, **VERNE A. MORRIS** of **GARVEY DRILLING COMPANY**

upon oath state that the above and foregoing is a true and correct copy of the log of the **#1 LANCASTER** well

Subscribed and sworn to before me this **9th** day of **November** 19**60**

My Commission Expires **November 12, 1962**

NOTARY PUBLIC