


STATE OF KANSAS
STATE CORPORATION COMMISSION

WELL PLUGGING RECORD

Give All Information Completely
Make Required Affidavit
Mail or Deliver Report to
Conservation Division
State Corporation Comm.
245 North Water
Wichita, KS 67202

Gove County, Sec. 32 Twp. 15S Rge. 28 E/W
Location as "NE/CNW $\frac{1}{4}$ SW $\frac{1}{4}$ " or footage from lines

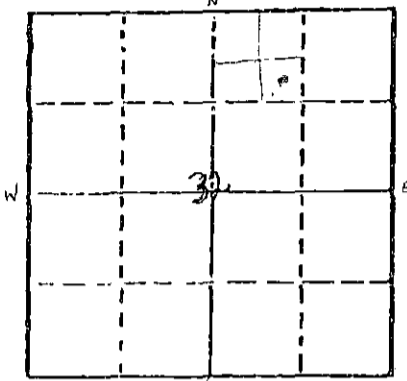

Locate well correctly on above
Section Plot

SE NW NE
Lease Owner Voyager Petroleum Inc. #7462 (R.B. Petrol.)
Lease Name Davis Well No. 32-2
Office Address 110 16th # 800; Denver, Colorado 80202
Character of Well (Completed as Oil, Gas or Dry Hole)

DRY HOLE
Date Well completed 8-9- 19 84
Application for plugging filed 8-8- 19 84
Application for plugging approved 8-8- 19 84
Plugging commenced 8-8- 19 84
Plugging completed 8-9- 19 84
Reason for abandonment of well or producing formation

Dry Hole
If a producing well is abandoned, date of last production 19

Was permission obtained from the Conservation Division or its agents before plugging was commenced? YES

Name of Conservation Agent who supervised plugging of this well Carl Goodrow
Producing formation Depth to top Bottom Total Depth of Well 4370'
Show depth and thickness of all water, oil and gas formations.

OIL, GAS OR WATER RECORDS

CASING RECORD

FORMATION	CONTENT	FROM	TO	SIZE	PUT IN	PULLED OUT
Surface		0	306'	8 5/8	300'	0

Describe in detail the manner in which the well was plugged, indicating where the mud fluid was placed and the method or methods used in introducing it into the hold. If cement or other plugs were used, state the character of same and depth placed, from feet to feet for each plug set.

4370' T.D. 185 Sacks 50-50 Posmix 6% Gel 3% cc
1st Plug at 1920' with 25 Sacks
2nd Plug at 850' with 100 Sacks
3rd Plug at 300' with 40 Sacks
Solid Bridge at 40' with 10 Sacks
Rathole with 10 Sacks
Plug down at 9:40 A.M. 8-9-84
Sun Cementing

(If additional description is necessary, use BACK of this sheet)

Name of Plugging Contractor Blue Goose Drilling Company, Inc. # 5104

STATE OF KANSAS COUNTY OF BARTON, ss.
George E. Miller, Jr. (employee of owner) or (owner or operator)
of the above-described well, being first duly sworn on oath, says: That I have knowledge of the facts, statements, and matters herein contained and the log of the above-described well as filed and that the same are true and correct. So help me God.

(Signature) George E. Miller, Jr.
P.O. Box 1413 Great Bend, KS 67530
(Address)

SUBSCRIBED AND SWORN TO before me this 10th day of August, 1984

Helen C. Standley
Notary Public.

My commission expires 12-8-87

HELEN C. STANDLEY
Barton County, Kansas
My Appt. Exp. 12-8-87

RECEIVED
STATE CORPORATION COMMISSION

AUG 29 1984

CONSERVATION DIVISION
Wichita, Kansas