


STATE OF KANSAS
STATE CORPORATION COMMISSION

WELL PLUGGING RECORD

Give All Information Completely
Make Required Affidavit
Mail or Deliver Report to:
Conservation Division
State Corporation Commission
800 Bittling Building
Wichita, Kansas

NORTH

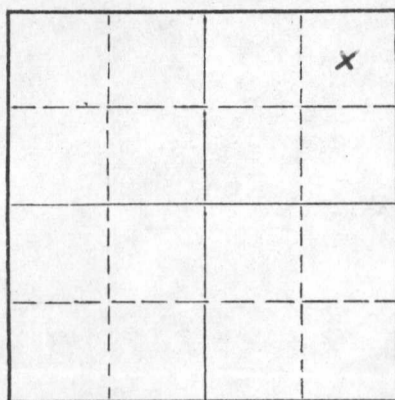

Locate well correctly on above
Section Plat

Meade County, Sec. 18 Twp. 35 Rge. 27 (E) W (W)
Location as "NE/CNW&SW" or footage from lines CNW 1/4 NW 1/4
Lease Owner Lloyd H. Smith Inc.
Lease Name Meyers Well No. 1
Office Address 403 City National Bank Bldg. Houston, Texas
Character of Well (completed as Oil, Gas or Dry Hole) Dry Hole
Date well completed 12/25/55 19
Application for plugging filed 12/23/55 19
Application for plugging approved 12/23/55 19
Plugging commenced 4:00 PM 12/26/55 19
Plugging completed 6:00 PM 12/26/55 19
Reason for abandonment of well or producing formation No Production

If a producing well is abandoned, date of last production _____ 19
Was permission obtained from the Conservation Division or its agents before plugging was commenced? Yes

Name of Conservation Agent who supervised plugging of this well M. A. Rives
Producing formation _____ Depth to top _____ Bottom _____ Total Depth of Well 6553 Feet
Show depth and thickness of all water, oil and gas formations.

OIL, GAS OR WATER RECORDS

CASING RECORD

FORMATION	CONTENT	FROM	TO	SIZE	PUT IN	PULLED OUT
				13 3/8	531'	None
				8 5/8	2565'	2074'

Describe in detail the manner in which the well was plugged, indicating where the mud fluid was placed and the method or methods used in introducing it into the hole. If cement or other plugs were used, state the character of same and depth placed, from _____ feet to _____ feet for each plug set.

Halliburton 13 3/8 Plug set on Bottom @ 500'
Cemented w/ 35 sks of common Cement 460' - 500'
Heavy roary mud 20' - 460'
Halliburton 13 3/8 Plug set on top @ 20'
Cemented W/ 15 sks of common Cement 5' - 20'

(If additional description is necessary, use BACK of this sheet)

Name of Plugging Contractor Halliburton
Address Liberal, Kansas

STATE OF Kansas, COUNTY OF Seward, ss.
Midwestern Drillers, Inc. (employee of owner) or (owner or operator) of the above-described well, being first duly sworn on oath, says: That I have knowledge of the facts, statements, and matters herein contained and the log of the above-described well as filed and that the same are true and correct. So help me God.

(Signature) C. N. Dunnam
816 N Jordan Liberal, Kansas
(Address)

SUBSCRIBED AND SWORN TO before me this 27 day of December, 1955

My commission expires 6/17/59

John B. Pinkerton
Notary Public.

PLUGGING
FILE SEC 18 T 35 R 27W
BOOK PAGE 27 LINE 28

RECEIVED
STATE CORPORATION COMMISSION
JAN 3 - 1956
1-3-56
CONSERVATION DIVISION
Wichita, Kansas

DRILLER'S LOG

OPERATOR: Lloyd H. Smith, Inc.
CONTRACTOR: Midwestern Drillers, Inc.
203 Wright Building
Tulsa 3, Oklahoma

ELEVATION
WELL COMMENCED: November 24, 1955
WELL COMPLETED: December 26, 1955

LEASE NAME: Imogene Meyers No. 1
LOCATION: Center NW/4, NW/4 Section 18,
T35S, R27W, Meade County, Kansas

TOTAL DEPTH: 6,553 ft. R.B.

CASING RECORD: Set 531.71' of 13-3/8" casing with 525 sacks Posmix cement
Set 2,565' of 8-5/8" casing with 200 sacks cement

FORMATION	Depth From Rotary Bushing
	0
Sand and red bed	490
Shale and sand	540 Ran 532' of 13-3/8" casing
Gypsum, shale and sand	920
Red bed, sand and anhydrite	1305
Anhydrite, shale and gypsum	1554
Anhydrite and shale	2101
Gypsum, shale and anhydrite	2265
Shale, sand and anhydrite	2383
Anhydrite and shale	5776 Ran 2565' of 8-5/8" csg.
Anhydrite and shale	2691
Lime and shale	2937
Lime and shale	3121
Sandy lime and shale	3273
Lime and shale	3563
Sandy lime and shale	3690
Lime and shale	4009
Shale and shells	4166
Lime and shale	4408
Sandy shale and shells	4545
Lime and shale	4654
Lime	4770
Lime and shale	5000
Lime	5048
Shale and Lime	5073
Lime and chert	5162
Lime and shale	5324
Lime	5417
Lime and shale	5612
Lime and shale	5723
Lime	5834
Lime and shale	6095
Lime, shale and sand	6149 Ran D.S.T. #1
Sandy lime and shale	6154
Shale and lime	6236
Lime and shale	6324
Lime and shale	6484
Lime and shale	6553 Ran Electric Log
	6553 D & A

I hereby certify that the above is a true and correct copy of Driller's Log of Lloyd H. Smith, Inc. Imogene Meyers No. 1 Well.

MIDWESTERN DRILLERS, INC.

By: C. Williams

Subscribed and sworn to before me this 30th day of December, 1955.

F. W. Wyatt
Notary Public

My Commission Expires:
August 12, 1956

