


STATE OF KANSAS  
STATE CORPORATION COMMISSION

WELL PLUGGING RECORD

Give All Information Completely  
Make Required Affidavit  
Mail or Deliver Report to:  
Conservation Division  
State Corporation Commission  
800 Bittling Building  
Wichita, Kansas

Made \_\_\_\_\_ County, Sec. 15 Twp. 35S Rge. XX 27 (W)  
Location as "NE/CNW&SW&" or footage from lines C Lot 2  
Lease Owner Rine Drlg. - Roberts & Murphy  
Lease Name Meyers Well No. 1  
Office Address 420 Union Center  
Character of Well (completed as Oil, Gas or Dry Hole) Dry Hole  
Date well completed 9/24 19 57  
Application for plugging filed 9/24 19 57  
Application for plugging approved 9/24 19 57  
Plugging commenced 9/25 19 57  
Plugging completed 9/25 19 57  
Reason for abandonment of well or producing formation Dry

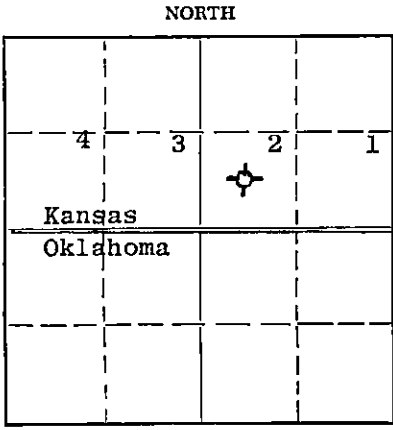

Locate well correctly on above  
Section Plat

If a producing well is abandoned, date of last production \_\_\_\_\_ 19\_\_\_\_  
Was permission obtained from the Conservation Division or its agents before plugging was commenced? yes

Name of Conservation Agent who supervised plugging of this well M. A. Rives  
Producing formation \_\_\_\_\_ Depth to top \_\_\_\_\_ Bottom \_\_\_\_\_ Total Depth of Well 6565 Feet  
Show depth and thickness of all water, oil and gas formations.

OIL, GAS OR WATER RECORDS

CASING RECORD

FORMATION	CONTENT	FROM	TO	SIZE	PUT IN	PULLED OUT
				13-3/8"	318'	
				8-5/8"	2635'	1874'

Describe in detail the manner in which the well was plugged, indicating where the mud fluid was placed and the method or methods used in introducing it into the hole. If cement or other plugs were used, state the character of same and depth placed, from \_\_\_\_\_ feet to \_\_\_\_\_ feet for each plug set.

Filled hole with very heavy mud from 6565' to 315'. Set Halliburton plug at 315'; Placed 35 sacks common cement on top of plug with drill pipe; Filled with very heavy mud to 20' below cellar; Set Halliburton plug at 26'; Tied with wire; Placed 15 sacks common cement on top of plug.

(If additional description is necessary, use BACK of this sheet)

Name of Plugging Contractor R. W. Rine Drilling Company  
Address \_\_\_\_\_

STATE OF Kansas, COUNTY OF Sedgwick, ss.  
Paul A. Harper (employee of owner) or (~~owner or operator~~) of the above-described well, being first duly sworn on oath, says: That I have knowledge of the facts, statements, and matters herein contained and the log of the above-described well as filed and that the same are true and correct. So help me God.

(Signature) Paul A. Harper  
420 Union Center, Wichita, Kansas  
(Address)

SUBSCRIBED AND SWORN TO before me this 1st day of October, 19 57

Charlene Barbour  
Notary Public.

My commission expires 7/28/58

24-7966-5 3-53-20M

**PLUGGING**

FILE SEC. 15 T. 35 R. 27W

BOOK PAGE 49 LINE 28

RECEIVED  
STATE CORPORATION COMMISSION

OCT 2 - 1957  
CONSERVATION DIVISION  
Wichita, Kansas

15-119-10283-0000

Ctr. Lot 2  
Sec. 15-35S-27W  
Meade County, Kansas

MEYERS WELL NO. 1

CONTRACTOR: The R. W. Rine Drilling Company

STARTED: August 29, 1957

COMPLETED: September 26, 1957

LOG

Sand & Red Bed	0' - 150'	
Red Bed	150' - 325'	Syfo. @150'-3/4 <sup>o</sup> , @325'-3/4 <sup>o</sup>
		13-3/8" Csg. @318' w/300 Sx.
Red Bed & Sand	325' - 855'	Syfo. @580'-1 1/4 <sup>o</sup> , @750'-1 1/2 <sup>o</sup>
Red Bed & Gyp	855' - 1115'	Syfo. @885'-1 <sup>o</sup> , @1040'-1/2 <sup>o</sup>
Anhydrite	1115' - 1237'	
Anhydrite & Red Bed	1237' - 1906'	Syfo. @1260'-1/2 <sup>o</sup> , @1500'-3/4 <sup>o</sup>
		Syfo. @1730'-1 1/2 <sup>o</sup> , @1830'-1 1/4 <sup>o</sup>
Shale & Anhydrite	1906' - 2338'	Syfo. @1980'-1 1/4 <sup>o</sup> , @2140'-1 1/2 <sup>o</sup>
Lime & Shale	2338' - 2518'	Syfo. @2330'-1 1/2 <sup>o</sup> , @2425'-3/4 <sup>o</sup>
Lime	2518' - 2570'	
Lime & Shale	2570' - 2634'	Syfo. @2575'-3/4 <sup>o</sup>
Lime	2634' - 2918'	Syfo. @2870'-1 1/4 <sup>o</sup> - 8-5/8" Csg. @2635'
Shale & Lime	2918' - 3007'	
Lime, Shale & Chalky Lime	3007' - 3129'	
Chalky Lime	3129' - 3730'	Syfo. @3210'-1/2 <sup>o</sup> , @3310'-3/4 <sup>o</sup>
		Syfo. @3700'-1/2 <sup>o</sup>
Chalky Lime & Shale	3730' - 3850'	
Shale & Lime	3850' - 4312'	
Shale	4312' - 5011'	
Lime	5011' - 4585'	
Lime & Shale	4585' - 4976'	
Lime	4976' - 6085'	Syfo. @4980'-3/4 <sup>o</sup> , @5205'-3/4 <sup>o</sup>
		Syfo. @5395'-3/4 <sup>o</sup> , @5500'-3/4 <sup>o</sup>
		Syfo. @5610'-1/2 <sup>o</sup> , @5884'-1 1/2 <sup>o</sup>
		Syfo. @5975'-1 <sup>o</sup>
Lime, Shale & Sand	6085' - 6120'	Syfo. @6110'-1 1/4 <sup>o</sup>
Lime & Shale	6120' - 6460'	Syfo. @6350'-2 <sup>o</sup> , @6320'-1 1/2 <sup>o</sup>
		Syfo. @6459'-1-3/4 <sup>o</sup>
Lime	6460' - 6565'	
		T. D.


STATE OF KANSAS )  
COUNTY OF SEDGWICK ) ss

I, R. M. Green, do hereby certify that the above is a true and accurate log of the Meyers Well No. 1, located Ctr. Lot 2 of Sec. 15-35S-27W, Meade County, Kansas

  
Ass't. Secretary and Treasurer

Subscribed and sworn to before me this 1st day of October, 1957.

PLUGGING  
FILE SEC. 15 T. 35 R. 27W  
BOOK PAGE 49 LINE 28

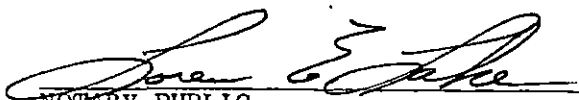  
NOTARY PUBLIC

My Commission Expires: 6/14/58