


STATE OF KANSAS
STATE CORPORATION COMMISSION

WELL PLUGGING RECORD

Give All Information Completely
Make Required Affidavit
Mail or Deliver Report to:
Conservation Division
State Corporation Commission
211 No. Broadway
Wichita, Kansas

Meade County. Sec. 10 Twp. 35S Rge. (E) 27 (W)
Location as "NE/CNW/SW" or footage from lines C - NE SW
Lease Owner Monsanto Chemical Company (Lion Oil Company Division)
Lease Name Imogene Well No. 1
Office Address P. O. Box 580, Pratt, Kansas
Character of Well (completed as Oil, Gas or Dry Hole) Dry Hole
Date well completed May 25, 19 57
Application for plugging filed May 25, 19 57
Application for plugging approved (Verbal) May 25, 19 57
Plugging commenced May 25, 19 57
Plugging completed May 25, 19 57
Reason for abandonment of well or producing formation Dry Hole

NORTH

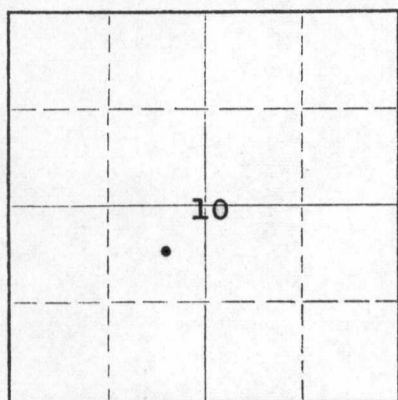

Locate well correctly on above
Section Plat

If a producing well is abandoned, date of last production _____ 19____
Was permission obtained from the Conservation Division or its agents before plugging was commenced? Yes

Name of Conservation Agent who supervised plugging of this well Mr. M. A. Rives
Producing formation _____ Depth to top _____ Bottom _____ Total Depth of Well 6525' Feet
Show depth and thickness of all water, oil and gas formations.

OIL, GAS OR WATER RECORDS

CASING RECORD

FORMATION	CONTENT	FROM	TO	SIZE	PUT IN	PULLED OUT
				8-5/8"	1610'	None

Describe in detail the manner in which the well was plugged, indicating where the mud fluid was placed and the method or methods used in introducing it into the hole. If cement or other plugs were used, state the character of same and depth placed, from _____ feet to _____ feet for each plug set.

Filled hole with heavy mud from 6525' to 1600'. Set Halliburton plug @ 1600' with 20 sacks of cement. Filled hole with heavy mud to 35'. Set Halliburton plug @ 35' with 1/3 sack of hulls and 10 sacks of cement to top of 8-5/8" casing.

RECEIVED
STATE CORPORATION COMMISSION
JUN 3 X 1957
CONSERVATION DIVISION
Wichita, Kansas
6-3-57

(If additional description is necessary, use BACK of this sheet)
Name of Plugging Contractor Garvey Drilling Company
Address 352 North Broadway, Wichita, Kansas

STATE OF KANSAS, COUNTY OF PRATT, ss.
Bruce E. Roll (employee of owner) or (owner or operator) of the above-described well, being first duly sworn on oath, says: That I have knowledge of the facts, statements, and matters herein contained and the log of the above-described well as filed and that the same are true and correct. So help me God.

(Signature) Bruce E. Roll
P. O. Box 580, Pratt, Kansas
(Address)

SUBSCRIBED AND SWORN TO before me this 28th day of May, 19 57

Merle H. Combs
Notary Public.

My commission expires September 19, 1959

PLUGGING
FILE SEC 10 T. 35 R. 27w
BOOK PAGE 15 LINE 33

WELL LOG

COMPANY **LION OIL COMPANY**

SEC. 10 T. 35S R. 27W

FARM **IMOGENE**

NO. **1**

LOC. **C/NE, SW**


TOTAL DEPTH **6525'**

COUNTY **Meade Co., Kansas**

COMM. **April 24, 1957**

COMP. **May 25, 1957**

CONTRACTOR **GARVEY DRILLING COMPANY**

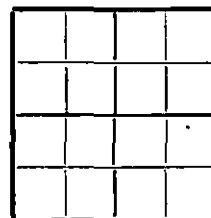

CASING **8 5/8" @ 1610' W/900 sax.**

ELEVATION **2283' DF**

PRODUCTION **D & A**

FIGURES INDICATE BOTTOM OF FORMATIONS	
285	Sand & shale
625	Red bed
1100	Red bed & shale
1610	Shale & shells
1620	Anhydrite
2075	Shale w/anhydrite & shells
2355	Shale & shells
2485	Anhydrite & shale
3255	Lime & shale
3375	Chalky lime & hard lime
3630	Lime & chalk
3705	Chalky lime & shale
3748	Lime & chalk
3850	Chalky lime & shale
4111	Shale
4490	Shale & shells
4570	Lime & shale
4695	Lime, shale & chert
5043	Lime
5082	Sandy lime
5202	Lime
5287	Lime & shale
5614	Lime
5665	Lime & shale
5691	Lime
5783	Lime & shale
5822	Lime
6040	Shale & lime
6117	Core hole.
6525	Lime
6525	T. D.

RECEIVED
 STATE CORPORATION COMMISSION
 JUN 29 1957
 CONSERVATION DIVISION
 Wichita, Kansas

PLUGGING
 FILE SEC. 10 T. 35 R. 27W
 BOOK PAGE 15 LINE 33

State of KANSAS
 County of BARTON } ss:

I, Verne A. Morris of Garvey Drilling Co.

upon oath state that the above and foregoing is a true and correct copy of the log of the #1 Imogene well

Verne A. Morris

Subscribed and sworn to before me this 6th day of June 19 57.

My Commission Expires: November 12, 1958

Blankenship
 NOTARY PUBLIC