

STATE OF KANSAS COMMISSION  
STATE CORPORATIONS  
Give Information Completely  
Make Required Affidavit  
Mail or Deliver Return  
Conservation Commission  
State Capitol Building  
211 No. Kansas  
Wichita

WELL PLUGGING RECORD

Meade County, Sec. 9 Twp. 35S Rge. 27W (E) (W)

Location as "NE/CNW/SW" or footage from lines 1980' f/WL & 1980' f/NL

Lease Owner Secure Trusts

Lease Name Elmer Meyers

Well No. 1

Office Address 1101 Elm Street, Dallas, Texas

Character of Well (completed as Oil, Gas or Dry Hole) Dry

Date well completed 3-17- 19 64

Application for plugging filed 11-15- 19 65

Application for plugging approved 11-20- 19 65


Plugging commenced 11-30- 19 65

Plugging completed 12-1- 19 65

Reason for abandonment of well or producing formation Non-Commercial

If a producing well is abandoned, date of last production Not produced to sale

Was permission obtained from the Conservation Division or its agents before plugging was commenced? yes

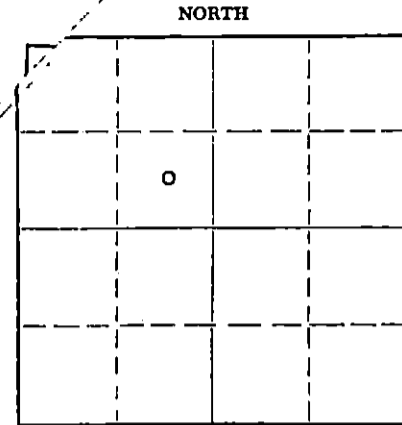

Locate well correctly on above Section Plat

Name of Conservation Agent who supervised plugging of this well Hugh E. Scott

Producing formation Council Grove Depth to top 3070 Bottom 3150 Total Depth of Well 3150 Feet

Show depth and thickness of all water, oil and gas formations.

OIL, GAS OR WATER RECORDS

CASING RECORD

FORMATION	CONTENT	FROM	TO	SIZE	PUT IN	PULLED OUT
Council Grove	Gas & S. Water	3014	3029	10-3/4"	420'	0
				4-1/2"	3150'	1820'

Describe in detail the manner in which the well was plugged, indicating where the mud fluid was placed and the method or methods used in introducing it into the hole. If cement or other plugs were used, state the character of same and depth placed, from \_\_\_\_\_ feet to \_\_\_\_\_ feet for each plug set.

Killed well w/9.6# Drilling mud. Spotted 25 sks. Common Cement 3025'-3000'. Displaced plug with drilling mud. NOTE: Baker Model "G" Packer and 27 Joints 2-3/8" Tubing were lost in hole after displacing lower plug. Spotted 60 sks. Common Cement 400'-300' after cutting off 4-1/2" Casing @ 1820'. Plug was displaced with drilling Mud. Set 30 sks. Common Cement 45'-0'. Cut 10-3/4" Surface Casing off 3' below ground level and welded 3/8" steel plate on same.

RECEIVED  
STATE CORPORATION COMMISSION

FEB 24 1966

CONSERVATION DIVISION  
Wichita, Kansas

(If additional description is necessary, use BACK of this sheet)

Name of Plugging Contractor JAC-KAF Well Service Inc.

Address Perryton, Texas

STATE OF Oklahoma, COUNTY OF Woodward, ss.  
Kenneth Cowan

(employee of owner) or (owner/operator) of the above-described well, being first duly sworn on oath, says: That I have knowledge of the facts, statements, and matters herein contained and the log of the above-described well as filed and that the same are true and correct. So help me God.

(Signature)

*Kenneth Cowan*

P.O. Box 681, Woodward, Oklahoma  
(Address)

SUBSCRIBED AND SWORN TO before me this 15 day of December, 19 65

*Ramona Hughes*

Notary Public.

My commission expires 12-18-68