


Give All Information Completely  
Make Required Affidavit  
Mail or Deliver Report to:  
Conservation Division  
State Corporation Commission  
211 No. Broadway  
Wichita, Kansas

WELL PLUGGING RECORD

Meade County, Sec. 4 Twp. 35S Rge. (E) 27 (W)

Location as "NE/CNW/SW" or footage from lines C/NE SW/4 SW/4  
Lease Owner Secure Trusts  
Lease Name Henry Johannsen Well No. 1  
Office Address 700 Mercantile Bank Bldg. Dallas, Texas  
Character of Well (completed as Oil, Gas or Dry Hole) Dry Hole  
Date well completed December 6, 19 63  
Application for plugging filed December 7, 19 63  
Application for plugging approved December 11, 19 63  
Plugging commenced December 7, 19 63  
Plugging completed December 7, 19 63  
Reason for abandonment of well or producing formation Dry Hole

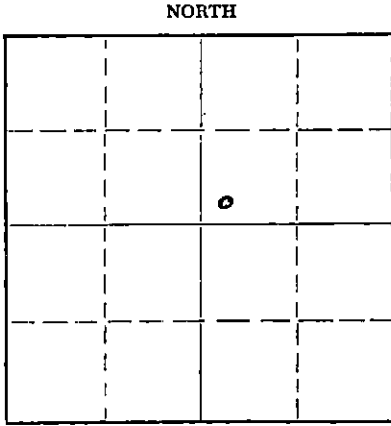

Locate well correctly on above Section Plat

If a producing well is abandoned, date of last production None 19       
Was permission obtained from the Conservation Division or its agents before plugging was commenced? Yes

Name of Conservation Agent who supervised plugging of this well Mr. Hugh Scott, Sublett, Kansas  
Producing formation None Depth to top      Bottom      Total Depth of Well 3169 Feet  
Show depth and thickness of all water, oil and gas formations.

OIL, GAS OR WATER RECORDS

CASING RECORD

FORMATION	CONTENT	FROM	TO	SIZE	PUT IN	PULLED OUT
Red Beds		0	1985	8-5/8	417.0	None
Anhydrite		1985	2670			
Lime and Shale		2670	2986			
Florence Flint		2986	3000			
Lime and Shale		3000	3101			
Council Grove		3101	3169			

Describe in detail the manner in which the well was plugged, indicating where the mud fluid was placed and the method or methods used in introducing it into the hole. If cement or other plugs were used, state the character of same and depth placed, from      feet to      feet for each plug set.

Hole filled with 9.5#/gallon, 45 second (Marsh funnel) viscosity mud with cotton seed hulls, added, through drill pipe using rotary mud pump. Laid down drill pipe and set 20 Sack Portland Common Cement plug from 700 feet up to 630 feet, 20 Sack Portland Common Cement plug from 400 feet up to 335 feet, 10 Sack Portland Common cement plug from 35 feet below ground level to ground level.

RECEIVED  
STATE CORPORATION COMMISSION

DEC 30 1963

12-30-63  
CONSERVATION DIVISION  
Wichita, Kansas

(If additional description is necessary, use BACK of this sheet)  
Name of Plugging Contractor Stickle Drilling Company  
Address Woodward, Oklahoma

STATE OF Oklahoma, COUNTY OF Woodward, ss.  
Secure Trusts (employee of owner) or (~~owner or operator~~) of the above-described well, being first duly sworn on oath, says: That I have knowledge of the facts, statements, and matters herein contained and the log of the above-described well as filed and that the same are true and correct. So help me God.

(Signature) Horace L. Conger  
1114-11<sup>th</sup> Woodward, Okla.  
(Address)

SUBSCRIBED AND SWORN TO before me this 27th day of December, 19 63

Buck J. Salmon  
Buck J. Salmon Notary Public.

My commission expires February 13, 1966

Operator: Secure Trusts  
Henry Johannsen No. 1  
SW SW NE Sec 4, 35S, 27W  
Meade County, Kansas

Contractor: Stickle Drilling Company  
Commenced : 11-29-63  
Completed : 12-7-63

Set 8-5/8" OD surface casing @ 417'  
and cemented with 200 sacks Posmix #1  
and 2% CaCl and 100 sacks Common with  
2% CaCl. Cement to surface.

Formations:	Red Beds	0 - 550
	Red Beds & Gypsum	550 - 745
	Red Beds	745 - 1280
	Gloretta Sand	1280 - 1385
	Anhydrite	1385 - 1505
	Red Beds	1505 - 1970
	Anhydrite	1970 - 2680
	Lime & Shale	2680 - 2938
	Florence Flint Zone	2938 - 2952
	Limy Shale	2952 - 2985
	Lime	2985 - 3050
	Shale & Lime	3050 - 3101
	Council Grove Lime	3101 - 3169
	Total Depth	3169

RECEIVED  
STATE CORPORATION COMMISSION

JAN 16 1964

CONSERVATION DIVISION  
Wichita, Kansas

I, Horace L. Conger, do certify the above log is true and correct to the best of my knowledge and belief.

*Horace L. Conger*  
Horace L. Conger  
Secure Trusts

Subscribed and sworn to me this 15th day of January, 1964

*Buck J. Salmon*  
Buck J. Salmon - Notary Public  
Woodward County, Oklahoma

My commission expires February 13, 1966.