


Give Information Completely
Make Required Affidavit
Mail or Deliver Report to:
Conservation Division
State Corporation Commission
211 No. Broadway
Wichita, Kansas

WELL PLUGGING RECORD

NORTH

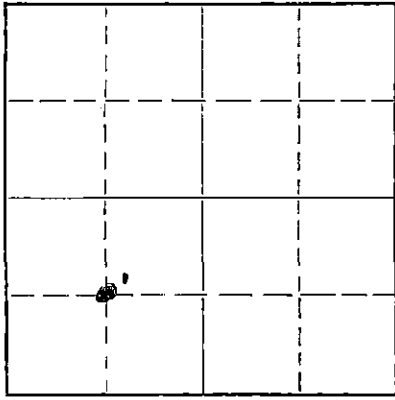

Locate well correctly on above Section Plat

Meade County, Sec. 2 Twp. 35S Rge. (E) 27 (W)
C SW/4

Location as "NE/CNWSW" or footage from lines _____
Lease Owner: An-Son Corporation
Lease Name: Fincham "A"
Office Address: 3814 N. Santa Fe, Okla City - Okla. Well No. 1
Character of Well (completed as Oil, Gas or Dry Hole) Dry hole
Date well completed 8-15 19 64
Application for plugging filed 19
Application for plugging approved 19
Plugging commenced 8-16 19 64
Plugging completed 8-16 19 64
Reason for abandonment of well or producing formation No porosity development

If a producing well is abandoned, date of last production _____ 19____
Was permission obtained from the Conservation Division or its agents before plugging was commenced? Yes

Name of Conservation Agent who supervised plugging of this well Hugh Scott 6520
Producing formation None Depth to top _____ Bottom _____ Total Depth of Well 6250 Feet
Show depth and thickness of all water, oil and gas formations.

OIL, GAS OR WATER RECORDS

CASING RECORD

FORMATION	CONTENT	FROM	TO	SIZE	PUT IN	PULLED OUT
Chester	None	6112	6520	8 5/8"	1537	None

Describe in detail the manner in which the well was plugged, indicating where the mud fluid was placed and the method or methods used in introducing it into the hole. If cement or other plugs were used, state the character of same and depth placed, from _____ feet to _____ feet for each plug set.

Two drill stem test in the Chester indicated no porosity. Recoveries were nil.
Hole was kept full of heavy rotary mud and a 35 sx plug set from 700 to 800' in 8-5/8" surface casing. A 15 sx cap was placed @ 0-45' all work performed to comply with Kansas Comm. Requirements.

RECEIVED
STATE CORPORATION COMMISSION

AUG 18 1964

8-18-64
CONSERVATION DIVISION
Wichita, Kansas

(If additional description is necessary, use BACK of this sheet)

Name of Plugging Contractor HOWCO
Address Liberal Kansas

STATE OF OKLAHOMA, COUNTY OF OKLAHOMA, ss.
RAYMOND PRICE (employee of owner) or (owner or operator) of the above-described well, being first duly sworn on oath, says: That I have knowledge of the facts, statements, and matters herein contained and the log of the above-described well as filed and that the same are true and correct. So help me God.

(Signature) Raymond Price
3814 N. Santa Fe Okla City, Okla.
(Address)

SUBSCRIBED AND SWORN TO before me this 17th day of August, 19 64

My commission expires June 22, 1966

Lalish Tidell
Notary Public.

