


STATE OF KANSAS
STATE CORPORATION COMMISSION

WELL PLUGGING RECORD

Give All Information Completely
Make Required Affidavit
Mail or Deliver Report to
Conservation Division
State Corporation Comm.
245 North Water
Wichita, KS 67202

Meade County. Sec. 9 Twp. 35 Rge. 26 E/W
Location as "NE/CNW $\frac{1}{4}$ SW $\frac{1}{4}$ " or footage from lines
CW 1/2 1320' FWL, 2640' FSL

Lease Owner _____
Lease Name Bernard Smith Well No. 1
Office Address 516 Bldg. of the SW, Midland Texas 79701
Character of Well (Completed as Oil, Gas or Dry Hole) _____
Dry Hole
Date Well completed November 22 1978
Application for plugging filed November 22 1978
Application for plugging approved November 22 1978
Plugging commenced 19:00 hr. November 22 1978
Plugging completed 21:50 hr. November 22 1978
Reason for abandonment of well or producing formation _____

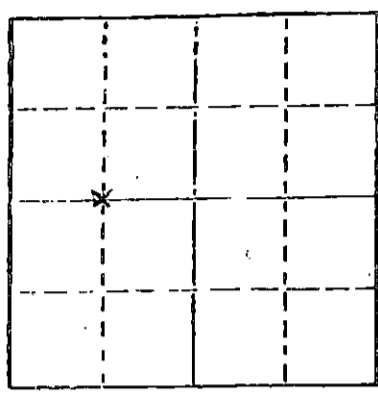

If a producing well is abandoned, date of last production _____ 19____
None

Was permission obtained from the Conservation Division or its agents before plugging was commenced? Yes

Name of Conservation Agent who supervised plugging of this well Clarence Thomas, Jr.
Producing formation None Depth to top _____ Bottom _____ Total Depth of Well _____
Show depth and thickness of all water, oil and gas formations.

OIL, GAS OR WATER RECORDS

CASING RECORD

FORMATION	CONTENT	FROM	TO	SIZE	PUT IN	PULLED OUT
<u>Red Bed</u>	<u>54 ft.</u>	<u>G.L.</u>	<u>54</u>	<u>20"</u>	<u>54 ft.</u>	<u>None</u>
<u>Anhydrite</u>	<u>1364 ft.</u>	<u>G.L.</u>	<u>1364</u>	<u>8 5/8"</u>	<u>1364</u>	<u>None</u>

Describe in detail the manner in which the well was plugged, indicating where the mud fluid was placed and the method or methods used in introducing it into the hold. If cement or other plugs were used, state the character of same and depth placed, from _____ feet to _____ feet for each plug set.

Halliburton Pumped Plugs.

1. 1400' - 60 Sacks Type "H" Cement - 16.4 Gal.

2. 40' To Surface - 20 Sacks Type "H" Cement - 16.4 Gal. Placed on Top of 8 5/8" Hawco Plug

3. 10 Sacks in Rat Hole - 10 Sacks in Mouse Hole - Type "H" Cement

4. 8 5/8" Csg. Cut off 3' Below G.L., Cap Welded on w/ Name & Legal on Cap.

(If additional description is necessary, use BACK of this sheet)

Name of Plugging Contractor Halliburton

STATE OF Kansas COUNTY OF Meade, ss.
James K. Carter (employee of owner) or (owner or operator)


of the above-described well, being first duly sworn on oath, says: That I have knowledge of the facts, statements, and matters herein contained and the log of the above-described well as filed and that the same are true and correct. So help me God.

(Signature) James K. Carter
Greenland, Arkansas
(Address)

SUBSCRIBED AND SWORN TO before me this 27th day of November, 19 78

Velma Harris
Notary Public.

My commission expires May 9, 1982

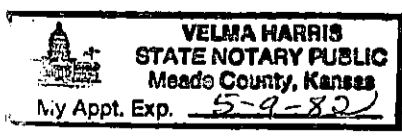

RECEIVED
STATE CORPORATION COMMISSION

DEC 11 1978

CONSERVATION DIVISION
Wichita, Kansas