

STATE OF KANSAS  
STATE CORPORATION COMMISSION


Give All Information Completely  
Make Required Affidavit  
Mail or Deliver Report to:  
Conservation Division  
State Corporation Commission

WELL PLUGGING RECORD

P. O. Box 17027  
Wichita, Kansas 67217  
NORTH

Meade County, Sec. 5 Twp. 35S Rge. (E) 26 (W)

Location as "NE/CNWxSWx" or footage from lines SE 1/4 NW 1/4  
Lease Owner Graham-Michaelis Corporation  
Lease Name Ediger (OWND) Well No. 1-5  
Office Address P. O. Box 247, Wichita, Kansas 67201  
Character of Well (completed as Oil, Gas or Dry Hole) Dry Hole  
Date well completed September 3, 19 73  
Application for plugging filed September 4, 19 73  
Application for plugging approved (Verbal) September 3, 19 73  
Plugging commenced September 3, 19 73  
Plugging completed September 3, 19 73  
Reason for abandonment of well or producing formation Non Commercial

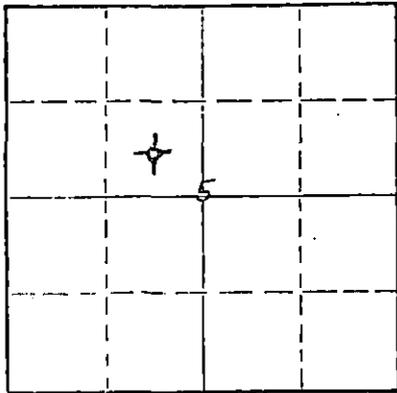

Locate well correctly on above  
Section Plat

If a producing well is abandoned, date of last production None 19  
Was permission obtained from the Conservation Division or its agents before plugging was commenced? Yes, verbal.

Name of Conservation Agent who supervised plugging of this well Edgar J. Eves, Sublette, Kansas, Box F 67877  
Producing formation None Depth to top Bottom Total Depth of Well 6475 Feet  
Show depth and thickness of all water, oil and gas formations.

OIL, GAS OR WATER RECORDS

CASING RECORD

FORMATION	CONTENT	FROM	TO	SIZE	PUT IN	PULLED OUT
				8"	1488'	none

Describe in detail the manner in which the well was plugged, indicating where the mud fluid was placed and the method or methods used in introducing it into the hole. If cement or other plugs were used, state the character of same and depth placed, from feet to feet for each plug set.

Filled with heavy mud to 1000' with 35 sacks cement, plug on top. Filled to 40' with heavy drilling mud, 45 sack cement plug to surface.

RECEIVED  
STATE CORPORATION COMMISSION  
SEP 5 1973  
CONSERVATION DIVISION  
Wichita, Kansas

(If additional description is necessary, use BACK of this sheet)

Name of Plugging Contractor Rine Drilling Company  
Address Suite 600, 300 West Douglas, Wichita, Kansas 67202

STATE OF Kansas, COUNTY OF Sedgwick, ss.  
Jack L. Yinger (employee of owner) or (owner or operator) of the above-described well, being first duly sworn on oath, says: That I have knowledge of the facts, statements, and matters herein contained and the log of the above-described well as filed and that the same are true and correct. So help me God.

(Signature) Jack L. Yinger  
P. O. Box 247, Wichita, Kansas 67201  
(Address)

SUBSCRIBED AND SWORN TO before me this 4th day of September, 19 73

MURIEL F. C. JERAM  
NOTARY PUBLIC  
SEDGWICK COUNTY, KANSAS  
MY COMMISSION EXPIRES  
JULY 25, 1976

Muriel F. C. Jeram  
Notary Public.