

STATE OF KANSAS
STATE CORPORATION COMMISSION

WELL PLUGGING RECORD

Give All Information Completely
Make Required Affidavit
Mail or Deliver Report to:
Conservation Division
State Corporation Commission
800 Bitting Building
Wichita, Kansas

Meade County. Sec. 5 Twp. 35 Rge. 26 (E) (W)

Location as "NE/CNW/SW" or footage from lines. C SE NW

Lease Owner. Sun Oil Company

Lease Name. H. N. Ediger Well No. 1

Office Address. Box 1348, Tulsa, Oklahoma

Character of Well (completed as Oil, Gas or Dry Hole) Dryhole

Date well completed 5-7-1960

Application for plugging filed 6-1-60 (verbal application 5-7-1960)

Application for plugging approved 5-7-1960


Plugging commenced 5-7-1960

Plugging completed 5-7-1960

Reason for abandonment of well or producing formation.

If a producing well is abandoned, date of last production 19

Was permission obtained from the Conservation Division or its agents before plugging was commenced? Yes

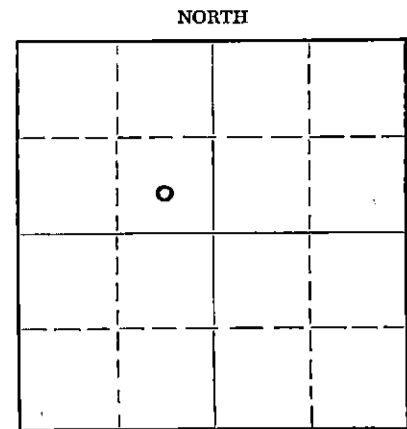

Locate well correctly on above Section Plat

Name of Conservation Agent who supervised plugging of this well Mr. Lackamp

Producing formation None Depth to top Bottom Total Depth of Well 6475 Feet

Show depth and thickness of all water, oil and gas formations.

OIL, GAS OR WATER RECORDS

CASING RECORD

FORMATION	CONTENT	FROM	TO	SIZE	PUT IN	PULLED OUT
None				20"	48'	None
				8-5/8"	1473.17'	None

Describe in detail the manner in which the well was plugged, indicating where the mud fluid was placed and the method or methods used in introducing it into the hole. If cement or other plugs were used, state the character of same and depth placed, from feet to feet for each plug set.

Spotted 20 sax cement 1400-1460' in 8-5/8" casing

Spotted 20 sax cement 490-550' in 8-5/8" casing

Capped with 10 sax cement 0-40' in 8-5/8" casing.

RECEIVED
STATE CORPORATION COMMISSION
JUN 3 1960
CONSERVATION DIVISION
Wichita, Kansas

(If additional description is necessary, use BACK of this sheet)

Name of Plugging Contractor Falcon Seaboard Drilling Company

Address Pan American Petroleum Building, Tulsa, Oklahoma

STATE OF OKLAHOMA, COUNTY OF TULSA, ss.

J. H. Allen (employee of owner) or (owner or operator) of the above-described well, being first duly sworn on oath, says: That I have knowledge of the facts, statements, and matters herein contained and the log of the above-described well as filed and that the same are true and correct. So help me God.

(Signature) J. H. Allen

Box 1348, Tulsa, Oklahoma (Address)

SUBSCRIBED AND SWORN TO before me this 2nd day of June, 1960

My commission expires July 25, 1962

Dorothy Little Notary Public.

WELL LOG

SUN OIL COMPANY
 H. N. Ediger No. 1
 C SE/4 NW/4
 Sec. 5, Twp. 35S, Rge. 26W
 Meade County, Kansas

<u>FORMATION</u>	<u>From</u>	<u>To</u>		
Red bed	0	659	Spudded	4-11-60
Lime, sand, shale & anhydrite	659	1500	Dry & Abandoned	5-7-60
Shale & lime	1500	1655	<u>CASING RECORD:</u>	
Lime and shale	1655	1830	20" at 48' w/6 yds. cement	
Lime w/thin strks sh	2830	3490	8-5/8" at 1488' w/850 sax Pozmix	
Lime and shale	3490	4395	<u>DRILL STEM TESTS</u>	
Lime	4395	4474	#1: 5969-6025' rec. 15' mud.	
Shale & lime	4474	4512	#2: 6383-6470' rec. 10' mud.	
Lime & shale	4512	4592	#3: 5962-5979' rec. 100' mud.	
Ls w/thin strks sh	4592	5800		
Shale & lime	5800	5874		
Morrow Shale	5874			
Sh w/l.s. strks	5874	5953		
Morrow Sand	5953	5964		
Miss. Chester	5968			
Lime & shale	5964	5998		
Shale	5998	6030		
Ls w/sh strks	6030	6164		
Shale	6164	6210		
Lime	6210	6250		
Limey shale	6250	6282		
Lime & shale	6282	6351		
Lime	6351	6405		
Shale	6405	6416		
Sdy. lime	6416	6443		
St. Genevieve Lmy. sd.	6443	6475		
		T.D.		

RECEIVED
 STATE CORPORATION COMMISSION
 JUN 3 1960
 CONSERVATION DIVISION
 Wichita, Kansas

I hereby certify that the foregoing is a true and correct copy of the H. N. Ediger No. 1 Well Log as recorded on the books of Sun Oil Company, Tulsa, Oklahoma.

J. H. Allen
 J. H. Allen

STATE OF OKLAHOMA)
) SS
 COUNTY OF TULSA)

Subscribed and sworn to before me this 2nd day of June, 1960.

Dorothy Little
 Notary Public

My Commission Expires:

July 25, 1962