


STATE OF KANSAS
STATE CORPORATION COMMISSION

Give All Information Completely
Make Required Affidavit
Mail or Deliver Report to:
Conservation Division
State Corporation Commission
211 No. Broadway
Wichita, Kansas

WELL PLUGGING RECORD

NORTH

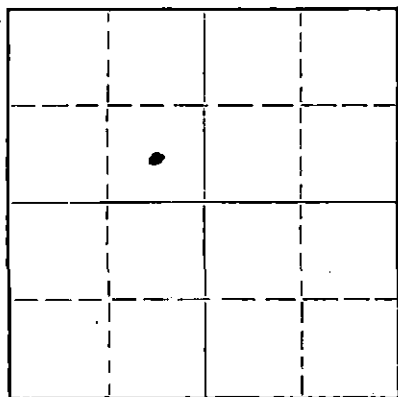

Locate well correctly on above
Section Plat

Meade County. Sec. 2 Twp. 35S Rge. ~~XX~~ 26 (W)
Location as "NE/CNW&SW&" or footage from lines C SE NW
Lease Owner. Gulf Oil Corporation
Lease Name. West-Higinbotham Well No. 1
Office Address. Box 661, Tulsa, Oklahoma
Character of Well (completed as Oil, Gas or Dry Hole) Dry hole
Date well completed. 12-12 19 57
Application for plugging filed. 12-12 19 57
Application for plugging approved Verbally 12-12-57 Letter 12-16- 19 57
Plugging commenced. 12-12 19 57
Plugging completed. 12-12 19 57
Reason for abandonment of well or producing formation Dry hole

If a producing well is abandoned, date of last production. - - 19 -
Was permission obtained from the Conservation Division or its agents before plugging was commenced? Yes

Name of Conservation Agent who supervised plugging of this well. M. A. Rives
Producing formation. Depth to top. Bottom. Total Depth of Well 6150 Feet
Show depth and thickness of all water, oil and gas formations.

OIL, GAS OR WATER RECORDS

CASING RECORD

FORMATION	CONTENT	FROM	TO	SIZE	PUT IN	PULLED OUT
				8-5/8"	1094'	0

Describe in detail the manner in which the well was plugged, indicating where the mud fluid was placed and the method or methods used in introducing it into the hole. If cement or other plugs were used, state the character of same and depth placed, from feet to feet for each plug set.

Filled hole with mud to 550'. Spotted bridge and 35 sx. cement. Filled with mud to 35' of surface. Spotted bridge and filled into cellar with 15 sx. cement.

Attached is Drillers Formation Record which was not available at time application was made.

NOTE: W. C. Bunch - Special Petty Cash, Check No. 1960, dated 10-23-57, in the amount of \$61.50, is attached as payment of plugging assessment.

RECEIVED
STATE CORPORATION COMMISSION

DEC 26 1957

CONSERVATION DIVISION
Wichita, Kansas

(If additional description is necessary, use BACK of this sheet)

Name of Plugging Contractor. Falcon Seaboard Drilling Company
Address. Pan American Building, Tulsa, Oklahoma

STATE OF Kansas, COUNTY OF Sedgwick, ss.
Thomas A. Trax (employee of owner) of the above-described well, being first duly sworn on oath, says: That I have knowledge of the facts, statements, and matters herein contained and the log of the above-described well as filed and that the same are true and correct. So help me God.


(Signature) *Thomas A. Trax*
Box 2233, Wichita, Kansas
(Address)

SUBSCRIBED AND SWORN TO before me this 23rd day of December, 1957

My commission expires 6-3-61

C. C. LEWIS, NOTARY PUBLIC Notary Public.

JRM:PF

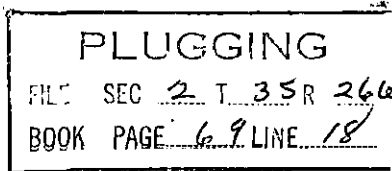

WELL LOG

COMPANY: Gulf Oil Corporation

Sec. 2-355-26W

FARM: West - Higinbotham No. 1

Loc. C SE NW

TOTAL DEPTH: 6150'

County - Meade

COMM: 11-8-57. COMP: 12-13-57.

CASING

8-5/8" -

ELEVATION

D.F. --

Gr. -

DRILLER'S LOG

Surface Soil & Sand	0	40
Sand & Red Bed	40	159
Red Bed, Sand w/Lime Stringers	159	734
Red Bed	734	1069
Anhydrite	1069	1096
Red Bed & Sand	1096	1301
Red Bed & Lime Stringers	1301	1510
Lime, Shale & Lime Stringers	1510	2000
Shale & Lime	2000	2160
Anhydrite & Lime	2160	2245
Anhydrite	2245	2405
Anhydrite & Shale	2405	2527
Anhydrite	2527	2706
Shale & Anhydrite	2706	2857
Anhydrite	2857	2891
Shale & Anhydrite	2891	2899
Lime & Shale	2899	3018
Lime & Shale (Sandy)	3018	3057
Lime & Shale	3057	4345
Shale	4345	4486
Shale & Lime	4486	4953
Shale & Lime (Chalky)	4953	5048
Lime & Shale	5048	5208
Lime	5208	5265
Lime & Shale	5265	5551
Lime	5551	5598
Lime & Shale	5598	5836
Lime, Sand & Shale	5836	5890
Lime & Shale	5890	5926
Shale & Sand	5926	6000
Sand, Shale & Lime	6000	6055
Lime	6055	6150

Total Depth

6150

RECEIVED
STATE CORPORATION COMMISSION

DEC 26 1957

CONSERVATION DIVISION
Wichita, Kansas

PLUGGING

FILE SEC 2 T 35 R 26W
BOOK PAGE 69 LINE 18