

STATE OF KANSAS
STATE CORPORATION COMMISSION


Give All Information Completely
Make Required Affidavit
Mail or Deliver Report to:
Conservation Division
State Corporation Commission
212 North Market, Insurance Bldg.
Wichita, Kansas

WELL PLUGGING RECORD

Meade County, Sec. 1 Twp. 35 Rge. 26^W (2) (W)

Location as "NE/CNW/SW" or footage from lines 1250' FEL & 1980' FNL
Lease Owner Ashland Oil & Refining Company
Lease Name Theis Well No. 5
Office Address 720 NW 50th Str, Oklahoma City, Oklahoma
Character of Well (completed as Oil, Gas or Dry Hole) Dry hole
Date well completed March 4 19 62
Application for plugging filed March 4 19 62
Application for plugging approved Verbal March 4 19 62
Plugging commenced March 4 19 62
Plugging completed March 4 19 62
Reason for abandonment of well or producing formation Dry hole

NORTH

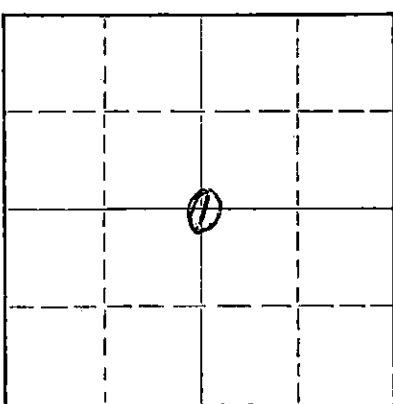

Locate well correctly on above Section Plat

If a producing well is abandoned, date of last production 19
Was permission obtained from the Conservation Division or its agents before plugging was commenced? Yes

Name of Conservation Agent who supervised plugging of this well
Producing formation None Depth to top Bottom Total Depth of Well 6133 Feet
Show depth and thickness of all water, oil and gas formations.

OIL, GAS OR WATER RECORDS

CASING RECORD

FORMATION	CONTENT	FROM	TO	SIZE	PUT IN	PULLED OUT
None						

Describe in detail the manner in which the well was plugged, indicating where the mud fluid was placed and the method or methods used in introducing it into the hole. If cement or other plugs were used, state the character of same and depth placed, from feet to feet for each plug set.

Filled the hole with heavy mud to 450, ran 40 sacks of cement and filled to 320.
Filled on top of cement with more heavy mud up to 30', and ran 10 sacks of cement to fill hole to surface. Welded cap on surface pipe.

RECEIVED
STATE CORPORATION COMMISSION
MAY 24 1962
CONSERVATION DIVISION
Wichita, Kansas

(If additional description is necessary, use BACK of this sheet)

Name of Plugging Contractor Graham-Michaelis Drilling Company
Address 211 N Broadway, Wichita, Kansas

STATE OF Oklahoma, COUNTY OF Oklahoma, ss.
Employee of owner (employee of owner) or (owner or operator) of the above-described well, being first duly sworn on oath, says: That I have knowledge of the facts, statements, and matters herein contained and the log of the above-described well as filed and that the same are true and correct. So help me God.

(Signature) K. H. Calvery
P. O. Box 9695, Oklahoma City, Oklahoma
(Address)

SUBSCRIBED AND SWORN to before me this 23rd day of May, 19 62

My commission expires 3-8-66

Jane La Rue Whitfield
Notary Public.



WELL RECORD:

LOCATION:

Section 1-35S-26W
Meade County, Kansas

Commenced: 1/31/62
Completed: 3/4/62
(Rotary)

CONTRACTOR:

Graham-Michaelis Drilling Co.
Liberal Division
P. O. Box 896
Liberal, Kansas

CASING RECORD:

18 Joints 8-5/8" 2 1/2" Casing
Cemented w/100 sx Pozmix 2 3/4 cc

4 well

	LOG	
Surface Sand & Red Bed	0 -	160
Red Bed	160 -	439
Dry Drilling	439 -	535
Red Bed	535 -	596
Dry Drilling	596 -	668
Red Bed & Shale	668 -	1118
Shale & Gyp	1118 -	1653
Shale	1653 -	2027

2027' - Total Rotary Depth

SKID RIO 75' SOUTH

	LOG	
Surface Sand & Red Bed	0 -	535
Dry Drilling	535 -	895
Shale	895 -	1035
Shale & Gyp	1035 -	1223
Sand	1223 -	1250
Sand & Shale	1250 -	1475
Red Bed	1475 -	1552
Shale & Gyp	1552 -	2212
Shale & Lime	2212 -	4260
Shale	4260 -	4472
Shale & Lime	4472 -	4851
Lime	4851 -	5344
Sandy Lime & Shale	5344 -	5364
Lime	5364 -	5711
Lime & Shale	5711 -	5754
Lime	5754 -	5920
Lime, Shale & Sand	5920 -	5975
Lime & Shale	5975 -	6160

5 well

RECEIVED
STATE CORPORATION COMMISSION
SEP - 9 1962
CONSERVATION DIVISION
Wichita, Kansas

6160' - Total Rotary Depth

The undersigned, Graham-Michaelis Drilling Company, Liberal Division, certifies that the above log is a true and correct copy of the formations encountered in drilling the above mentioned well, as taken from the Daily Drilling Report.

GRAHAM-MICHAELIS DRILLING COMPANY
LIBERAL DIVISION

By H. R. Michaelis
H. R. Michaelis