

STATE OF KANSAS
STATE CORPORATION COMMISSION
200 Colorado Derby Building
Wichita, Kansas 67202

WELL PLUGGING RECORD
K.A.R.-82-3-117

API NUMBER 15-119-20,476-0000

LEASE NAME THEIS

WELL NUMBER 1-1

SPOT LOCATION 660'FNL & 1980'FWL

SEC. 1 TWP. 35 SRGE. 26 (E) of (W)

COUNTY Meade

Date Well Completed 3-12-81

Plugging Commenced 5-11-82

Plugging Completed 5-14-82

AMENDED REPORT.

TYPE OR PRINT
NOTICE: Fill out completely
and return to Cons. Div.
office within 30 days.

LEASE OPERATOR Hawkins Oil & Gas, Inc.

ADDRESS 400 S. Boston, Suite 800, Tulsa, OK 74103

PHONE # (918) 585-3121 OPERATORS LICENSE NO. 6378

Character of Well Gas
(Oil, Gas, D&A, SWD, Input, Water Supply Well)

Did you notify the KCC/KDHE Joint District Office prior to plugging this well? Yes

Which KCC/KDHE Joint Office did you notify? _____

Is ACO-1 filed? Yes If not, is well log attached? _____

Producing formation Chester Depth to top 5994' bottom 5998' T.D. 6350'

Show depth and thickness of all water, oil and gas formations.

OIL, GAS OR WATER RECORDS

CASING RECORD

Formation	Content	From	To	Size	Put In	Pulled out
				8 5/8"	802	None
				4 1/2"	6324'	4398'

Describe in detail the manner in which the well was plugged, indicating where the mud fluid was placed and the method or methods used in introducing it into the hole. If cement or other plugs were used state, the character of same and depth placed, from ___ feet to ___ feet each set.

Plugged as follows:

Spotted 20 sx. plug @ 5800'
Spot 35 sx. plug from 825-725'
Spot 10 sx. plug from 33-3'
Job complete @ 10:00 a.m. 5-14-82

(If additional description is necessary, use BACK of this form.)

Name of Plugging Contractor Sargent Casing Pulling Service License No. #6547

Address Box 506 Liberal, KS 67901

Original CP4 filed 5-18-84, casing information incorrectly reported. Previous CP-4 attached

STATE OF Oklahoma COUNTY OF Tulsa, ss.

Kathy B. McGuire

(employee of operator) or

(operator) of above-described well, being first duly sworn on oath, says: That I have knowledge of the facts and statements, and matters herein contained and the log of the above-described well as filed that the same are true and correct, so help me God.

RECEIVED
STATE CORPORATION COMMISSION

AUG 10 1984

(Signature) Kathy B. McGuire

(Address) 400 S. Boston, Suite 800
Tulsa, OK 74103

CONSERVATION DIVISION
WICHITA, KANSAS

SUBSCRIBED AND SWORN TO before me this 8th day of August, 1984

[Signature]
Notary Public


My Commission expires: Oct. 1985

STATE OF KANSAS
STATE CORPORATION COMMISSION

WELL PLUGGING RECORD

Give All Information Completely
Make Required Affidavit
Mail or Deliver Report to
Conservation Division
State Corporation Comm.
245 North Water
Wichita, KS 67202

Meade County, Sec. 1 Twp. 355 Rge. 26 E(W)
Location as "NE/CNW 1/4 SW 1/4" or footage from lines
660' FNL & 1980' FWL
Lease Owner Hawkins Oil & Gas, Inc.
Lease Name Theis Well No. 1-1
Office Address 320 S. Boston, Suite 701, Tulsa, OK 74103
Character of Well (Completed as Oil, Gas or Dry Hole)

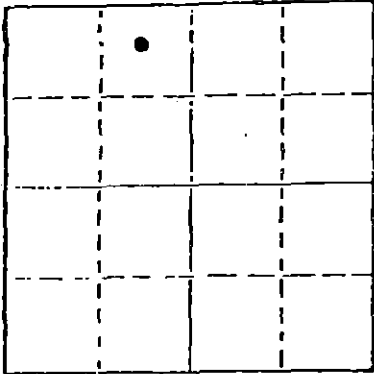

Locate well correctly on above
Section Plot

Gas
Date Well completed 3-12 1981
Application for plugging filed 2-12 1982
Application for plugging approved 2-17 1982
Plugging commenced 5-11 1982
Plugging completed 5-14 1982
Reason for abandonment of well or producing formation
uneconomical to produce
If a producing well is abandoned, date of last production
10-22 1981

Was permission obtained from the Conservation Division or
its agents before plugging was commenced? yes

Name of Conservation Agent who supervised plugging of this well Paul Luthi
Producing formation Chester Depth to top Bottom Total Depth of Well 6350'
Show depth and thickness of all water, oil and gas formations.

OIL, GAS OR WATER RECORDS

CASING RECORD

FORMATION	CONTENT	FROM	TO	SIZE	PUT IN	PULLED OUT
				4 1/2"	6324'	6324'

Describe in detail the manner in which the well was plugged, indicating where the mud fluid
was placed and the method or methods used in introducing it into the hold. If cement or other
plugs were used, state the character of same and depth placed, from _____ feet to
_____ feet for each plug set.

Plugged as follows:

Spotted 20 sx. plug @ 5800'.
Spot 35 sx. plug from 825-725'.
Spot 10 sx. plug from 33-3'.
Job complete @ 10:00 a.m. 5/14/82.

(If additional description is necessary, use BACK of this sheet)

Name of Plugging Contractor Sargent Casing Pulling Service

STATE OF Oklahoma COUNTY OF Tulsa, ss.
Kathy B. McGuire (employee of owner) or (owner or operator)
of the above-described well, being first duly sworn on oath, says: That I have knowledge of
the facts, statements, and matters herein contained and the log of the above-described well
as filed and that the same are true and correct. So help me God.

(Signature) Kathy B. McGuire
320 S. Boston, Suite 701, Tulsa, OK 74103
(Address)

SUBSCRIBED AND SWORN TO before me this 18th day of May, 1982

[Signature]
Notary Public.

My commission expires Oct 6, 1985

RECEIVED
STATE CORPORATION COMMISSION

MAY 20 1982
CONSERVATION DIVISION
Wichita Kansas

WELL LOG

COMPANY Hawkins Oil & Gas, Inc.

SEC. 1-35-26W

FARM Theis NO. 1-1


LOC. C NE NW

TOTAL DEPTH 6350'

COUNTY Meade, Ks.

COMM. 2-14-81 COMP. 2-23-81

CONTRACTOR Zenith Drilling Corporation

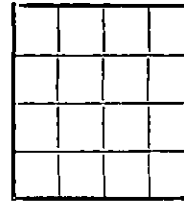

Ran 20 jts. new 24#, 8 5/8" casing, set at 802' with 400 sacks cement

Ran 150 jts. new 10 1/2#, 4 1/2" casing, set at 6324' with 250 sacks cement

ELEVATION

PRODUCTION

FIGURES INDICATE BOTTOM OF FORMATIONS

804	Sand & Red Bed
2080	Red Bed
2690	Red Bed & Shale
5800	Lime & Shale
5985	Lime, Morrow Sand & Shale
6275	Lime & Shale
6350	Lime

RECEIVED
 STATE CORPORATION COMMISSION
 FEB 17 1982
 CONSERVATION DIVISION
 Wichita, Kansas

State of KANSAS }
 County of SEDGWICK } SS

I, Emmet E. Hall of Zenith Drilling Corporation

upon oath state the above and foregoing is a true and correct copy of the log of the Theis #1-1 well.

Emmet E. Hall

Subscribed and sworn to before me this 26th day of February, 19 81.

My Commission Expires: 12/15/84

Sharon R. Allen
 Sharon R. Allen NOTARY PUBLIC