


STATE OF KANSAS  
STATE CORPORATION COMMISSION

WELL PLUGGING RECORD

Give All Information Completely  
Make Required Affidavit  
Mail or Deliver Report to  
Conservation Division  
State Corporation Comm.  
245 North Water  
Wichita, KS 67202

Meade County, Sec. 1 Twp. 35S Rge. 26 **XW**  
Location as "NE/CNW $\frac{1}{4}$ SW $\frac{1}{4}$ " or footage from lines  
2310'FSL & 2310'FWL  
Lease Owner Hawkins Oil & Gas, Inc.  
Lease Name Theis Well No. 2-1  
Office Address 320 So. Boston, Suite 701, Tulsa, OK 74103  
Character of Well (Completed as Oil, Gas or Dry Hole)

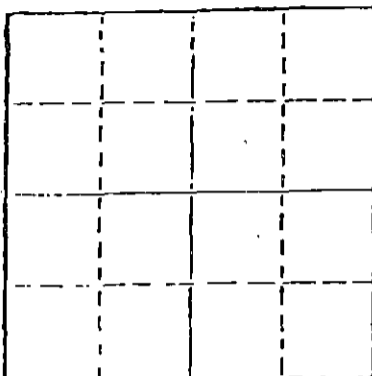

Locate well correctly on above  
Section Plat

Dry Hole  
Date Well completed 3/22 1981  
Application for plugging filed 3/22 1981  
Application for plugging approved 3/22 1981  
Plugging commenced 3/22 1981  
Plugging completed 7:30 p.m. 3/22 1981  
Reason for abandonment of well or producing formation  
no commercial quantity of oil or gas encountered  
If a producing well is abandoned, date of last production  
N/A 19

Was permission obtained from the Conservation Division or  
its agents before plugging was commenced? yes

Name of Conservation Agent who supervised plugging of this well Clarence Thomas  
Producing formation \_\_\_\_\_ Depth to top \_\_\_\_\_ Bottom \_\_\_\_\_ Total Depth of Well 6350'  
Show depth and thickness of all water, oil and gas formations.

OIL, GAS OR WATER RECORDS

CASING RECORD

FORMATION	CONTENT	FROM	TO	SIZE	PUT IN	PULLED OUT
				8 5/8"	792'	None

Describe in detail the manner in which the well was plugged, indicating where the mud fluid was placed and the method or methods used in introducing it into the hold. If cement or other plugs were used, state the character of same and depth placed, from \_\_\_\_\_ feet to \_\_\_\_\_ feet for each plug set.

Well plugged as follows:

- 60 sacks of cement @ 800'
- 25 sacks of cement @ 400'
- 10 sacks of cement @ 40-0'
- 5 sacks of cement in mouse hole
- 5 sacks of cement in rat hole

RECEIVED  
STATE CORPORATION COMMISSION

(If additional description is necessary, use BACK of this sheet)

Name of Plugging Contractor B-J Hughes

APR - 2 1981  
4-2-81  
CONSERVATION DIVISION  
Wichita, Kansas

STATE OF Oklahoma COUNTY OF Tulsa, ss.  
D.S. Tipton (~~XXXXXXXXXXXXXXXXXXXX~~) or (owner or operator)  
of the above-described well, being first duly sworn on oath, says: That I have knowledge of the facts, statements, and matters herein contained and the log of the above-described well as filed and that the same are true and correct. So help me God.

(Signature)

320 So. Boston, Suite 701, Tulsa, OK 74103  
(Address)

SUBSCRIBED AND SWORN TO before me this 31st day of March, 1981

Carla Hylton  
Notary Public.

My commission expires March 13, 1983

# WELL LOG

COMPANY Hawkins Oil & Gas, Inc.

SEC. 1-35-26W

FARM Theis

NO. 2-1

LOC. 2310' FSL & 2310 FWL


TOTAL DEPTH 6350

COUNTY Meade, Ks.

COMM. 3-12-81

COMP. 3-21-81

CONTRACTOR

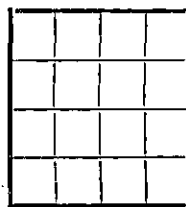

<sup>CASING</sup>  
Ran 20 jts., new 23#, 8 5/8" csg., set at 792' with 475 sacks cement

ELEVATION

PRODUCTION

FIGURES INDICATE BOTTOM OF FORMATIONS

1235	Red Bed
1848	Red Bed & Sand
2270	Red Bed
2590	Red Bed & Shells
6350	Lime & Shale

### PLUGGING INFORMATION

60 sacks cement at 800'  
 25 sacks cement at 400'  
 10 sacks cement at 40 - 0'  
 5 sacks cement in mouse hold and  
 5 sacks cement in rat hole

Job Complete 7:30 P.M. March 22, 1981

RECEIVED  
 CORPORATION COMMISSION  
 APR - 2 1981  
 CONSERVATION DIVISION  
 Wichita, Kansas

State of KANSAS }  
 County of SEDGWICK } ss

I, Emmet E. Hall of Zenith Drilling Corporation  
 upon oath state the above and foregoing is a true and correct copy of the log of the Theis #2-1 well.

Subscribed and sworn to before me this 25th day of March, 1981.

My Commission Expires: Dec. 15, 1984

Sharon R. Allen  
 Sharon R. Allen NOTARY PUBLIC