


STATE OF KANSAS
STATE CORPORATION COMMISSION

WELL PLUGGING RECORD

Give All Information Completely
Make Required Affidavit
Mail or Deliver Report to
Conservation Division
State Corporation Comm.
245 North Water
Wichita, KS 67202

Clark County, Sec. 10 Twp. 35S Rge. 23W E/W
Location as "NE/CNW $\frac{1}{4}$ SW $\frac{1}{4}$ " or footage from lines
C NE/4

Lease Owner Petro-Lewis Corporation
Lease Name Dunne Well No. 1-10
Office Address 5400 N. Independence, Okla. City, Ok 73112
Character of Well (Completed as Oil, Gas or Dry Hole)
Dry

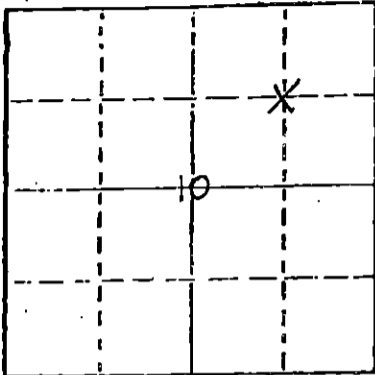

Locate well correctly on above
Section Plot

Date Well completed 7-25 19 82
Application for plugging filed 7-24 19 82
Application for plugging approved 7-24 19 82
Plugging commenced 7-25 19 82
Plugging completed 7-25 19 82
Reason for abandonment of well or producing formation
Dry

If a producing well is abandoned, date of last production
19

Was permission obtained from the Conservation Division or
its agents before plugging was commenced? Yes

Name of Conservation Agent who supervised plugging of this well Paul Luthi
Producing formation Depth to top Bottom Total Depth of Well 6151
Show depth and thickness of all water, oil and gas formations.

OIL, GAS OR WATER RECORDS

CASING RECORD

FORMATION	CONTENT	FROM	TO	SIZE	PUT IN	PULLED OUT
		0	100	20"		
			749	8 5/8"		

Describe in detail the manner in which the well was plugged, indicating where the mud fluid
was placed and the method or methods used in introducing it into the hold. If cement or other
plugs were used, state the character of same and depth placed, from feet to
feet for each plug set.

Plugged:
40 sacks set @ 1280'
35 sacks set @ 750'
40 sacks set @ 15'
10 sacks in rathole; 10 sacks in mousehole.
Completed @ 5:30 PM 7-25-82
Cemented by Halliburton

(If additional description is necessary, use BACK of this sheet)

Name of Plugging Contractor DaMac Drilling Inc.
Box 1164, Great Bend, Kansas 67530

STATE OF Kansas COUNTY OF Barton ss.

Martha J. McKown (employee of owner) or (owner or operator) of the above-described
well, being first duly sworn on oath, says: That I have knowledge of the facts, statements, and matters herein contained and the log of the
above-described well as filed and that the same are true and correct. So help me God.

(Signature) Martha J. McKown
Box 1164, Great Bend, Ks, 67530
(Address)

Subscribed and sworn to before me this 25th day of July 19 82

My commission expires Jan. 30, 1984

Vada J. Sullivan
Notary Public.



STATE CORPORATION COMMISSION


AUG 18 1982

CONSERVATION DIVISION
Wichita, Kansas

WELL LOG

COMPANY Petro-Lewis Corporation
 FARM Dunne NO. 1-10
 TOTAL DEPTH 6151 RTD
 COMM. 7-12-82 COMP. 7-25-82
 CONTRACTOR DaMac Drilling Inc.

SEC. 10 T. 35S R. 23W
 LOC. C, NE/4
 COUNTY Clark, Kansas.

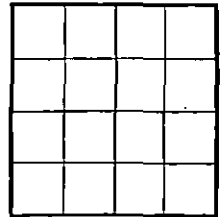

CASING Conductor: 20" set @ 100'
 Surface: 8 5/8" set @ 749'

ELEVATION
 PRODUCTION P&A

FIGURES INDICATE BOTTOM OF FORMATIONS

Surface Sand	0	100
RedBed, Shale	100	541
Shale	541	1431
Lime, Shale	1431	6151 RTD

RECEIVED
 STATE CORPORATION COMMISSION
 AUG 18 1982
 CONSERVATION DIVISION
 Wichita, Kansas

State of Kansas }
 County of Barton } SS

I, Martha J. McKown of DaMac Drilling Inc.
 upon oath state the above and foregoing is a true and correct copy of the log of the Dunne 1-10 well.



Martha J. McKown

Subscribed and sworn to before me this 25th day of July 1982

My Commission Expires: Jan. 30, 1984

Vada I. Sullivan
 NOTARY PUBLIC

15-025-20606-0000



**BULK MATERIALS DELIVERY
AND
TICKET CONTINUATION**

FOR INVOICE AND
TICKET NO. _____

DATE 7-25-82	CUSTOMER ORDER NO.	WELL NO. AND FARM Dunne 1-10	COUNTY Clark	STATE Kansas
CHARGE TO Petro Lewis		OWNER Petro Lewis	CONTRACTOR Demac	
MAILING ADDRESS		DELIVERED FROM Hugoton, Kansas	LOCATION CODE 50335	PREPARED BY Ron Rogers
CITY & STATE		DELIVERED TO SW of Ashland, Kansas	TRUCK NO.	RECEIVED BY
				No. B112417

PRICE REFERENCE	SECONDARY REF. OR PART NO.	CODE		DESCRIPTION	UNITS 1		UNITS 2		UNIT PRICE	AMOUNT	
		L	D		QTY.	MEAS.	QTY.	MEAS.			
504-043				Southwestern Type B	120	ske			6.39	768	80
507-277				Halliburton Gel added 2% (2)	120				.37	44	40
509-406				Calcium Chloride w/120 cnt.	3	ske			21.00	63	00
<p>RECEIVED STATE CORPORATION COMMISSION JUL 28 1982 CONSERVATION DIVISION Wichita, Kansas</p>											
				Returned Mileage Charge							
				TOTAL WEIGHT		LOADED MILES		TON MILES			
				SERVICE CHARGE ON MATERIALS RETURNED				CU. FEET			
00-207				SERVICE CHARGE				CU. FEET 126	.95	119	70
00-306				Mileage Charge	11,715	62		384.095	.70	254	87
				TOTAL WEIGHT		LOADED MILES		TON MILES			
B 112417									CARRY FORWARD TO INVOICE		SUB-TOTAL
											144 77