


STATE OF KANSAS  
STATE CORPORATION COMMISSION  
CONSERVATION DIVISION  
P. O. BOX 17027  
WICHITA, KANSAS 67217

FORM CP-4

WELL PLUGGING RECORD

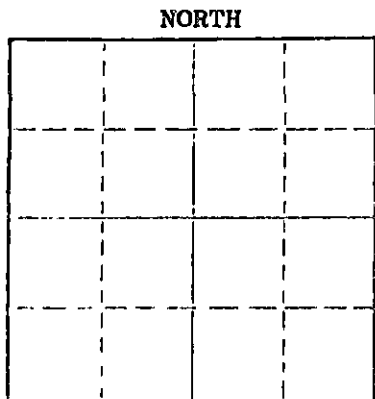

Locate well correctly on above Section Plat

Clark County, Sec. 9 Twp. 35S Rge. (E) 22 (W)  
Location as "NE/CNWSW" or footage from lines C E/2 NW  
Lease Owner Robert L. Haynie  
Lease Name Barth Well No. 1  
Office Address 4155 E. Jewell Avenue, Denver, Colorado 80222  
Character of Well (completed as Oil, Gas or Dry Hole) Dry Hole  
Date well completed July 6 1974  
Application for plugging filed July 5 1974  
Application for plugging approved July 5 1974  
Plugging commenced July 5 1974  
Plugging completed July 6 1974  
Reason for abandonment of well or producing formation Dry Hole

If a producing well is abandoned, date of last production None 19  
Was permission obtained from the Conservation Division or its agents before plugging was commenced? Yes

Name of Conservation Agent who supervised plugging of this well Edgar Eaves  
Producing formation \_\_\_\_\_ Depth to top \_\_\_\_\_ Bottom \_\_\_\_\_ Total Depth of Well 5702 Feet  
Show depth and thickness of all water, oil and gas formations.

OIL, GAS OR WATER RECORDS

CASING RECORD

FORMATION	CONTENT	FROM	TO	SIZE	PUT IN	PULLED OUT
		0	636'	8 5/8	636'	None

Describe in detail the manner in which the well was plugged, indicating where the mud fluid was placed and the method or methods used in introducing it into the hole. If cement or other plugs were used, state the character of same and depth placed, from \_\_\_\_\_ feet to \_\_\_\_\_ feet for each plug set.

Plugged with 35 sacks @ 631', 15 sacks @ 40',  
2 sacks in rat hole, 2 sacks in mouse hole,  
Completed @ 3:00 A.M. 7-6-74  
Cemented by Allied Cementing Company.

RECEIVED  
STATE CORPORATION COMMISSION  
JUL 18 1974  
CONSERVATION DIVISION  
Wichita, Kansas

(If additional description is necessary, use BACK of this sheet)  
Name of Plugging Contractor DaMac Drilling Company  
Address Box 1164, Great Bend, Kansas 67530

STATE OF Kansas COUNTY OF Barton ss.

\_\_\_\_\_, being first duly sworn on oath, says: That I have knowledge of the facts, statements, and matters herein contained and the log of the above-described well as filed and that the same are true and correct. So help me God.

CHARLENE M. MARKER  
NOTARY PUBLIC  
Barton County, Kansas  
My Commission Expires  
September 13, 1977

(Signature) Martha J. McKown  
Box 1164, Great Bend, Kansas 67530  
(Address)

SUBSCRIBED AND SWORN to before me this 8 day of July, 1974

My commission expires September 13, 1977 Notary Public.

# WELL LOG

COMPANY Robert L. Haynie

SEC. 9 T. 35S R. 22W

FARM Barth

NO. 1

LOC. C E/2 NW 4


TOTAL DEPTH 5800'

COUNTY Clark, Kansas

COMM. 6-17-74

COMP. 7-6-74

CONTRACTOR DaMac Drilling Company, Inc.

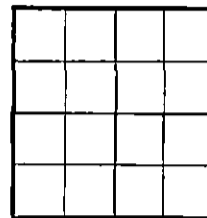

CASING

8 5/8" @ 631 w/ 675 sx

ELEVATION

PRODUCTION D & A

FIGURES INDICATE BOTTOM OF FORMATIONS

- 30 Sand
- 494 Shale
- 636 Shale & Red Bed
- 1979 Shale
- 2275 Shale & Lime
- 2360 Lime
- 2490 Lime & Shale
- 2570 Shale & Lime
- 2715 Lime
- 2920 Lime & Shale
- 4215 Shale & Lime
- 4298 Lime & Shale
- 4608 Lime
- 4736 Lime & Shale
- 4872 Lime
- 5702 RTD

RECEIVED  
 STATE CORPORATION COMMISSION  
 JUL 18 1974  
 CONSERVATION DIVISION  
 Wichita, Kansas

State of KANSAS }  
 County of BARTON } ss

I, Karen K. Hickerson of DaMac Drilling Company, Inc.

upon oath state the above and foregoing is a true and correct copy of the log of the Barth No. 1 well.

CHARLENE M. MARKER  
 NOTARY PUBLIC  
 Barton County, Kansas  
 My Commission Expires  
 September 13, 1977  
 Subscribed and sworn to before me this

*Karen K. Hickerson*

12th day of July 19 74

My Commission Expires: September 13, 1977

*Charlene M. Marker*  
 NOTARY PUBLIC