


STATE OF KANSAS
STATE CORPORATION COMMISSION

Give All Information Completely
Make Required Affidavit
Mail or Deliver Report to:
Conservation Division
State Corporation Commission
211 No. Broadway
Wichita, Kansas

WELL PLUGGING RECORD

Clark County, Sec. 9 Twp. 35 Rge. 22 (E) (W)

Location as "NE/CNW%SW%" or footage from lines NW/SW
Lease Owner Lone Star Exploration, Inc.
Lease Name Noble-Cook Well No. 1
Office Address 2010 Republic National Bank Bldg., Dallas, Tex.
Character of Well (completed as Oil, Gas or Dry Hole) gas
Date well completed December 23, 19 58
Application for plugging filed April 13 19 67
Application for plugging approved April 20 19 67
Plugging commenced April 20 19 67
Plugging completed April 26 19 67
Reason for abandonment of well or producing formation depleted

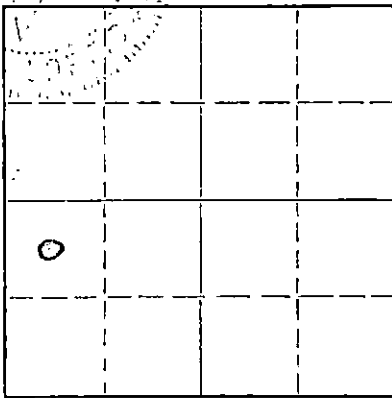

Locate well correctly on above
Section Plat

If a producing well is abandoned, date of last production November 19 66

Was permission obtained from the Conservation Division or its agents before plugging was commenced? yes

Name of Conservation Agent who supervised plugging of this well Ed Eaves

Producing formation Morrow Depth to top 5736 Bottom 5748 Total Depth of Well 5748 Feet

Show depth and thickness of all water, oil and gas formations.

OIL, GAS OR WATER RECORDS

CASING RECORD

FORMATION	CONTENT	FROM	TO	SIZE	PUT IN	PULLED OUT
<u>Morrow</u>	<u>gas</u>	<u>5736</u>	<u>5748</u>	<u>13 3/8</u>	<u>425</u>	<u>0</u>
				<u>8 5/8</u>	<u>2480</u>	<u>1500</u>
				<u>5 1/2</u>	<u>5738</u>	<u>3032</u>

Describe in detail the manner in which the well was plugged, indicating where the mud fluid was placed and the method or methods used in introducing it into the hole. If cement or other plugs were used, state the character of same and depth placed, from _____ feet to _____ feet for each plug set.


Well was pumped full of heavy mud and cement plugs were set as follows:

25 sacks from 5548 to 5748

50 sacks from 355 to 520

15 sacks in top of surface pipe

A steel plate was welded over the top of the surface pipe.

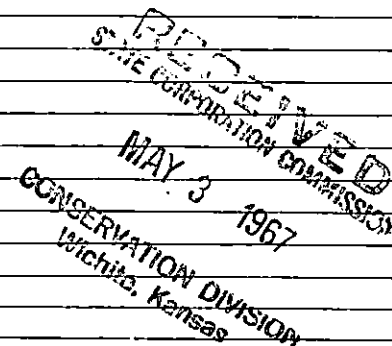

(If additional description is necessary, use BACK of this sheet)
Name of Plugging Contractor Gayle E. Toland
Address Box 94336, Oklahoma City, Oklahoma

STATE OF Texas, COUNTY OF Dallas, ss.
employee of owner (employee of owner) or (owner or operator) of the above-described

well, being first duly sworn on oath, says: That I have knowledge of the facts, statements, and matters herein contained and the log of the above-described well as filed and that the same are true and correct. So help me God.

(Signature) [Signature]
2010 Rep. Nat. Bank Bldg., Dallas, Tex.
(Address)

SUBSCRIBED AND SWORN TO before me this 2 day of May, 19 67

6-1-67

Stella M. Thompson
Notary Public.

