


15-025-00043-0000

STATE OF KANSAS
STATE CORPORATION COMMISSION
Give All Information Completely
Make Required Affidavit
Mail or Deliver Report to:
Conservation Division
State Corporation Commission
212 North Market, Insurance Bldg.
Wichita, Kansas

WELL PLUGGING RECORD

Clark County, Sec. 8 Twp. 35 Rge. (E) 22 (W)
Location as "NE/CNW/SW" or footage from lines C-NW-NW
Lease Owner Union Oil Company of California
Lease Name C. H. Tuttle "D" Well No. 1
Office Address Oklahoma City, Oklahoma
Character of Well (completed as Oil, Gas or Dry Hole) Gas
Date well completed December 31 19 58
Application for plugging filed May 18, 19 67
Application for plugging approved May 19, 19 67
Plugging commenced June 3, 19 67
Plugging completed June 10, 19 67
Reason for abandonment of well or producing formation Depleted

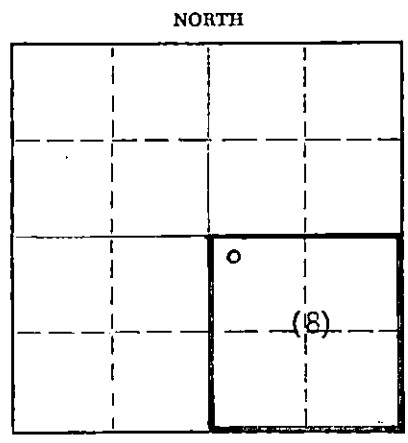

Locate well correctly on above Section Plat

If a producing well is abandoned, date of last production May 1966
Was permission obtained from the Conservation Division or its agents before plugging was commenced? Yes

Name of Conservation Agent who supervised plugging of this well Mr. E. Eves P.O. Box "F" Sublette, Kansas
Producing formation Morrow Depth to top 5630' Bottom 5678' Total Depth of Well 5935' Feet
Show depth and thickness of all water, oil and gas formations.

OIL, GAS OR WATER RECORDS				CASING RECORD		
FORMATION	CONTENT	FROM	TO	SIZE	PUT IN	PULLED OUT
Morrow	Gas	5630'	5678'	13-3/8"	558'	None
				5-1/2"	5747'	4367'

Describe in detail the manner in which the well was plugged, indicating where the mud fluid was placed and the method or methods used in introducing it into the hole. If cement or other plugs were used, state the character of same and depth placed, from _____ feet to _____ feet for each plug set.

A cast iron plug was set in this well upon completion in December 1958 @ 5700'.

6-3-67
M.I.R.U. csg. pullers. Shot 5 1/2' casing off @ 4424', unable to pull. shot casing off @ 4331' pulled & recovered 4367' of 5 1/2" OD casing. Filled hole w/hvy mud from 5700' to 5160', Spotted 20 sx. cmt. plug from 5160' to 5000', filled hole w/hvy mud from 5000' to 550', spotted 40 sx. cmt. plug from 550' to 500', filled hole w/hvy drlg. mud from 500' to 20', spotted 15 sx. cmt. plug from 20' to surface & welded a steel cap on top of 13-3/8" casing string. Well plugged and abandoned 6-10-67.

RECEIVED
JUN 16 1967
CONSERVATION DIVISION
Wichita, Kansas

(If additional description is necessary, use BACK of this sheet)
Name of Plugging Contractor Lillard Casing Pullers Inc.
Address Woodward, Oklahoma

STATE OF Oklahoma COUNTY OF Oklahoma, ss.
J. D. Norman (employee of owner) of the above-described well, being first duly sworn on oath, says: That I have knowledge of the facts, statements, and matters herein contained and the log of the above-described well as filed and that the same are true and correct. So help me God.

(Signature) J. D. Norman
7th Floor South Building - 2000 Classen Center
Oklahoma City, Oklahoma 73105
(Address)

SUBSCRIBED AND SWORN TO before me this 15th day of June 19 67
My commission expires April 14, 1968
Notary Public.

