

STATE OF KANSAS
STATE CORPORATION COMMISSION


Form CP-4

Give All Information Completely
Make Required Affidavit
Mail or Deliver Report to:
Conservation Division
State Corporation Commission
P. O. Box 17027
Wichita, Kansas 67217
NORTH

WELL PLUGGING RECORD

Clark County, Sec. 7 Twp. 35S Rge. 22 (E) X (W)
C. NE/4 (550' S)

Location as "NE/CNW/SW" or footage from lines
Lease Owner: Robert L. Haynie
Lease Name: Tuttle Well No. 5
Office Address: 802 Colorado Club Bldg, 4155 E Jewell Avn, Denver CO 80222
Character of Well (completed as Oil, Gas or Dry Hole) dry hole
Date well completed 10-27-74 19 74
Application for plugging filed 10-27-74 19 74
Application for plugging approved 10-27-74 19 74
Plugging commenced 10-27-74 19 74
Plugging completed 10-27-74 19 74
Reason for abandonment of well or producing formation commercial quantities of oil not found.

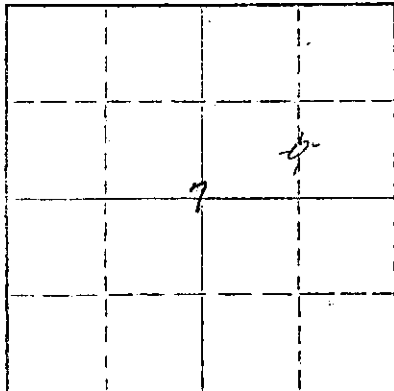

Locate well correctly on above Section Plat

If a producing well is abandoned, date of last production 19
Was permission obtained from the Conservation Division or its agents before plugging was commenced? yes

Name of Conservation Agent who supervised plugging of this well G. R. Biberstein

Producing formation _____ Depth to top _____ Bottom _____ Total Depth of Well _____ Feet
Show depth and thickness of all water, oil and gas formations.

OIL, GAS OR WATER RECORDS

CASING RECORD

FORMATION	CONTENT	FROM	TO	SIZE	PUT IN	PULLED OUT
				8-5/8"	15jts	

Describe in detail the manner in which the well was plugged, indicating where the mud fluid was placed and the method or methods used in introducing it into the hole. If cement or other plugs were used, state the character of same and depth placed, from _____ feet to _____ feet for each plug set.

Plug well @ 300' w/40 sacks, @ 40' w/15 sacks.
2 1/2 sacks in mouse hole. 2 1/2 sacks in rat hole.

RECEIVED
STATE CORPORATION COMMISSION
DEC 4 1974
CONSERVATION DIVISION
Wichita, Kansas

(If additional description is necessary, use BACK of this sheet)

Name of Plugging Contractor _____
Address _____

STATE OF COLORADO COUNTY OF DENVER, ss.
Robert L. Haynie (employee of owner) or (owner or operator) of the above-described

well, being first duly sworn on oath, says: That I have knowledge of the facts, statements, and matters herein contained and the log of the above-described well as filed and that the same are true and correct. So help me God.

(Signature) Robert L. Haynie
4155 E. Jewell Ave. - Suite 802
Denver, Colo. 80222 (Address)

SUBSCRIBED AND SWORN to before me this 29th day of November, 1974

My commission expires 7/24/77

Notary Public

ROBERT L. HAYNIE
 802 Colorado Club Building
 4155 E. Jewell Avenue
 Denver, Colorado
 80222

RECEIVED
 STATE CORPORATION COMMISSION
 DEC 4 1974
 CONSERVATION DIVISION
 Wichita, Kansas

DRILLERS WELL LOG

Tuttle #5 (550' So.)
 Commenced R.T. 10-17-74 C NE/4 - Section 7-35S-22W
 Completed R.T. 10-27-74 Clark County, Kansas
 Rotary Total Depth 5750' Elevation:
 Contractor: Thomas Drilling Co.

STRATA	DEPTH
Redbed	0 - 350
Redbed & Shale	350 - 1200
Shale	1200 - 2095
Anhydrite	2095 - 2244
Lime & Shale	2244 - 3566
Lime	3566 - 3845
Lime & Shale	3845 - 4034
Lime	4034 - 4425
Lime & Shale	4425 - 4600
Lime	4600 - 5750 TD

I hereby certify that the above is a true and correct log of said well as reflected by the daily drilling reports.

THOMAS DRILLING CO.

By John Voss
 John Voss

SIGNED AND SWORN TO IN MY PRESENCE
 THIS 11TH DAY OF NOVEMBER, 1974, BY
 JOHN VOSS, REPRESENTATIVE OF
 THOMAS DRILLING CO.

Josephine Bentley
 Josephine Bentley,
 NOTARY PUBLIC



My Commission expires: 3-24-75