

WELL PLUGGING RECORD

Give All Information Completely
Make Required Affidavit
Mail or Deliver Report to:
Conservation Division
State Corporation Commission
111 No. Broadway
Wichita, Kansas

Morton

County. Sec. 6 Twp. 34 Rge. (E) 43 (W)

Location as "NE/CNWxSWx" or footage from lines G NW SE

Lease Owner Anadarko Production Company

Lease Name Williams "E" Well No. 1

Office Address P. O. Box 351, Liberal, Kansas

Character of Well (completed as Oil, Gas or Dry Hole) Dry Hole

Date well completed May 9 19 62

Application for plugging filed May 8 19 62

Application for plugging approved May 8 19 62


Plugging commenced May 8 19 62

Plugging completed May 9 19 62

Reason for abandonment of well or producing formation Dry Hole

If a producing well is abandoned, date of last production 19

Was permission obtained from the Conservation Division or its agents before plugging was commenced? Yes

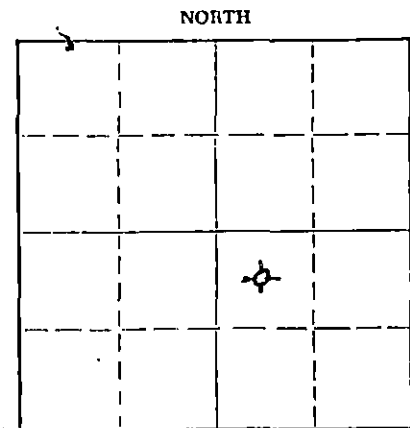

Locate well correctly on above Section Plat

Name of Conservation Agent who supervised plugging of this well Mr. W. L. Lackamp

Producing formation None Depth to top Bottom Total Depth of Well 4978 Feet

Show depth and thickness of all water, oil and gas formations.

OIL, GAS OR WATER RECORDS

CASING RECORD

FORMATION	CONTENT	FROM	TO	SIZE	PUT IN	PULLED OUT
				13 3/8	633	None
				8 5/8	1369	759'

Describe in detail the manner in which the well was plugged, indicating where the mud fluid was placed and the method or methods used in introducing it into the hole. If cement or other plugs were used, state the character of same and depth placed, from feet to feet for each plug set.

Filled hole with mud from 4978' to 3200', spotted 200 sacks cement from 3200' to 2750'. Ran Free Point. Cut off 8-5/8" casing @ 640'. Filled hole with mud from 2750' to 650', spotted 25 sacks cement from 650' to 624'. Filled hole with mud from 624' to 25', spotted 25 sacks cement from 25' to 4' below surface.

RECEIVED
STATE CORPORATION COMMISSION
MAY 15 1962
CONSERVATION DIVISION

(If additional description is necessary, use BACK of this sheet)

Name of Plugging Contractor Anadarko Production Company

Address P. O. Box 351, Liberal, Kansas

STATE OF KANSAS, COUNTY OF SEWARD ss.

R. L. O'Shields (employee of owner) or owner or operator of the above-described well, being first duly sworn on oath, says: That I have knowledge of the facts, statements, and matters herein contained and the log of the above-described well as filed and that the same are true and correct. So help me God.

(Signature) R. L. O'Shields, Vice President
P. O. Box 351, Liberal, Kansas (Address)

SUBSCRIBED AND SWORN TO before me this 11th day of May, 19 62

Ronald L. Vengerson Notary Public.

My commission expires MY COMMISSION EXPIRES SEPT. 29, 1964

DRILLER'S LOG

WELL NAME Williams "E" #1 COMPANY OPERATING Anadarko Production Company
 ADDRESS of COMPANY Box 351, Liberal, Kansas
 WELL LOCATION C 1/2 NW 1/2 SE 1/2,
1980 ft. North of South line,
2683 ft. East of West line; Sec. 6 Twp. 34 Rge. 43, Morton County, Kansas
 DRILLING STARTED April 2, 1962 DRILLING COMPLETED May 9, 1962
 WELL COMPLETED May 9, 1962 WELL CONNECTED _____, 19____
 ELEVATION 3700 ft. Ground Level CHARACTER OF WELL (Oil, Gas, or Dry Hole) Dry Hole

OIL OR GAS SANDS OR ZONES - PERFORATIONS - ACIDIZING AND FRACTURING INFORMATION					
Name	From	To	No. of Shots	Gallons Used	Kind Used
No Perforations					

CASING RECORD

Size	Amount Set	Sacks of Cement	Amount Pulled
13 3/8	633	200	None
8 5/8	1369	200	759

FORMATION RECORD

Formation	Top	Bottom	Formation	Top	Bottom
Surface Clay, Sand, Gypsum & Red Bed	0	365			
Red Bed Stks & Anhydrite	365	1260			
Anhydrite & Gypsum	1260	1370			
Red Bed & Anhydrite Shale	1370	2145			
Lime & Shale	2145	4480			
Sand & Shale	4480	4549			
Shale & Lime	4549	4635			
Shale & Sand	4635	4698			
Lime & Shale & Sand	4698	4978			
Total Depth	4978				

RECEIVED
 STATE CORPORATION COMMISSION
 MAY 15 1962
 CONSERVATION DIVISION
 Wichita, Kansas

RESULTS of INITIAL PRODUCTION TEST: Plugged & Abandoned