


STATE OF KANSAS
STATE CORPORATION COMMISSION

WELL PLUGGING RECORD

Give All Information Completely
Make Required Affidavit
Mail or Deliver Report to
Conservation Division
State Corporation Comm.
245 North Water
Wichita, KS 67202

Morton County, Sec. 3 Twp. 34S Rge. 43 E/W
Location as "NE/CNW 1/4 SW 1/4" or footage from lines 1250' FS&W Lines
Lease Owner ANADARKO PRODUCTION COMPANY
Lease Name INTERSTATE "O" Well No. 1
Office Address P. O. BOX 351, LIBERAL, KANSAS 67901
Character of Well (Completed as Oil, Gas or Dry Hole) Dry Hole
Date Well completed 4/27 1978
Application for plugging filed 4/13 1978
Application for plugging approved 4/18 1978
Plugging commenced 4/27 1978
Plugging completed 4/27 1978
Reason for abandonment of well or producing formation Non Productive
If a producing well is abandoned, date of last production NA 19
Was permission obtained from the Conservation Division or its agents before plugging was commenced? Yes

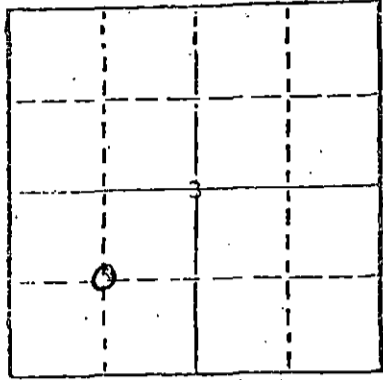

Name of Conservation Agent who supervised plugging of this well Clarence Thomas
Producing formation _____ Depth to top _____ Bottom _____ Total Depth of Well 1415'
Show depth and thickness of all water, oil and gas formations.

OIL, GAS OR WATER RECORDS

CASING RECORD

FORMATION	CONTENT	FROM	TO	SIZE	PUT IN	PULLED OUT
Red Cave	Wtr & Small Show gas	1376'	1380'	8-5/8"	378'	None
Red Cave	" " " " "	1372'	1376'	4-1/2"	1414	None

Describe in detail the manner in which the well was plugged, indicating where the mud fluid was placed and the method or methods used in introducing it into the hold. If cement or other plugs were used, state the character of same and depth placed, from _____ feet to _____ feet for each plug set.

Spotted 140 sacks of cement from 1380' to 3' through tubing. Pulled tubing, leaving casing full of cement.

RECEIVED
STATE CORPORATION COMMISSION
MAY 08 1978
CONSERVATION DIVISION
Wichita, Kansas

(If additional description is necessary, use BACK of this sheet)

Name of Plugging Contractor None

STATE OF KANSAS COUNTY OF SEWARD, ss.
Paul Campbell (employee of owner) or (XXXXXXXXXXXXXXXXXX)
of the above-described well, being first duly sworn on oath, says: That I have knowledge of the facts, statements, and matters herein contained and the log of the above-described well as filed and that the same are true and correct. So help me God.

(Signature) Paul Campbell, Division Production Manager

O. Box 351, Liberal, Kansas 67901 (Address)

SUBSCRIBED AND SWORN TO before me this 2nd day of May, 1978

LEONA FERNE CORNELSEN
Seward County, Kansas
My Appointment Expires
June 23, 1980

Leona Ferne Cornelsen
Notary Public.

My commission expires June 23, 1980

15-129-20331-0000

KANSAS DRILLERS LOG

S. 3 T. 34S R. 43 ^X/_W

API No. 15 — 129 — 20,331
County Number

Loc. ^{Opp} C SW/4

County Morton


Operator

ANADARKO PRODUCTION COMPANY

640 Acres
N

Address

P. O. BOX 351, LIBERAL, KANSAS 67901

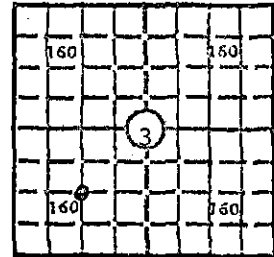

Well No.

1

Lease Name

INTERSTATE "O"

Footage Location

1250 feet from (X) (S) line

1250 feet from (X) (W) line

Principal Contractor

Gabbert-Jones, Inc.

Geologist

None

Spud Date

9/2/77

Total Depth

1415'

P.B.T.D.

1378'

Locate well correctly

Elev.: Gr. 3626.3'

Date Completed

Oil Purchaser

DF _____ KB _____

CASING RECORD

Report of all strings set—surface, intermediate, production, etc.

Purpose of string	Size hole drilled	Size casing set (in O.D.)	Weight lbs/ft.	Setting depth	Type cement	Sacks	Type and percent additives
Surface	12-1/4"	8-5/8"	20#	378'	Common	300	3% cc
Production	7-7/8"	4-1/2"	10.5#	1414'	Lite Wate Poz	200 150	4% gel 0.2% D-31

LINER RECORD

PERFORATION RECORD

Top, ft.	Bottom, ft.	Sacks cement	Shots per ft.	Size & type	Depth interval
			3	Sch. 3-3/8 Hyper II	1376-80'
			2	McCullough	1372-76'

TUBING RECORD

Size	Setting depth	Packer set at

ACID, FRACTURE, SHOT, CEMENT SQUEEZE RECORD

Amount and kind of material used	Depth interval treated
1,000 gals 7-1/2% Fe Acid w/Clay stabilizer	1376-80'
Squeeze cmt'd w/100 sxs Common	1376-80'
500 gals Acetic Acid, 1000 gals 7-1/2% Fe	1372-76'

RECEIVED
STATE CORPORATION
APR 18 1978
CONSERVATION DIVISION
Wichita, Kansas

INITIAL PRODUCTION

Date of first production	Producing method (flowing, pumping, gas lift, etc.)				
Non-Productive	Swab Test on 11/1/77				
RATE OF PRODUCTION PER 24 HOURS	Oil	Gas	Water	Gas-oil ratio	CFPB
	0 bbls.	TSTM	MCF	2.5BPH bbls.	
Disposition of gas (vented, used on lease or sold)				Producing interval (s)	

INSTRUCTIONS: As provided in KCC Rule 82-2-125, within 90 days after completion of a well, one completed copy of this Drillers Log shall be transmitted to the State Geological Survey of Kansas, 4150 Monroe Street, Wichita, Kansas 67209. Copies of this form are available from the Conservation Division, State Corporation Commission, 3830 So. Meridian (P.O. Box 17027), Wichita, Kansas 66217. Phone AC 316-522-2206. If confidential custody is desired, please note Rule 82-2-125. Drillers Logs will be on open file in the Oil and Gas Division, State Geological Survey of Kansas, Lawrence, Kansas 66044.

Operator: ANADARKO PRODUCTION COMPANY
 DESIGNATE TYPE OF COMP.: OIL, GAS, DRY HOLE, SWDW, ETC.: DRY HOLE

Well No. 1 Lease Name INTERSTATE "O"
 S 3 T 34SR 43^{EX}W

WELL LOG
 Show all important zones of porosity and contents thereof; cored intervals, and all drill-stem tests, including depth interval tested, cushion used, time tool open, flowing and shut-in pressures, and recoveries.
 SHOW GEOLOGICAL MARKERS, LOGS RUN, OR OTHER DESCRIPTIVE INFORMATION.

FORMATION DESCRIPTION, CONTENTS, ETC.	TOP	BOTTOM	NAME	DEPTH
Surface Clay-Sand-Redbed	0'	330'	Welex	
Redbed	330'	400'	Acoustic	377-1409'
Redbed-Anhy-Sand	400'	940'	Velocity	
Anhy-Sand-Anhy	940'	1415'	Gamma	
TOTAL DEPTH		1415'	Caliper Log	
PBTD		1378'		
			Welex Fracture	
			Finder Micro-Seismo	
			Gram Log	400-1407'
			Schlumberger	
			Neutron Log	830-1400'
			Schlumberger	
			Perforating	
			Depth Control	800-1352'

USE ADDITIONAL SHEETS, IF NECESSARY, TO COMPLETE WELL RECORD.

Date Received: _____
 Signature: *Paul Campbell*
 Paul Campbell, Division Production Manager
 Title: _____
 Date: April 12, 1978
 Date: _____