


15-129-00138-0000

STATE OF KANSAS  
STATE CORPORATION COMMISSION

WELL PLUGGING RECORD

Give All Information Completely  
Make Required Affidavit  
Mail or Deliver Report to:  
Conservation Division  
State Corporation Commission  
800 Bitting Building  
Wichita, Kansas

Morton County, Sec. 34 Twp. 34 Rge. 42<sup>nd</sup> (E) (W)  
Location as "NE/CNWSW" or footage from lines 330'S & 330'E of ~~Center Section~~ W.W. Carner

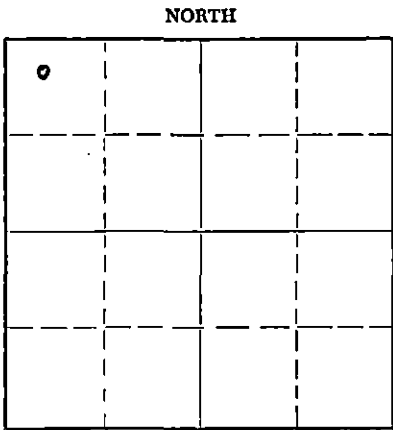

Locate well correctly on above  
Section Plat

Lease Owner Terminal Facilities, Inc.  
Lease Name Roll "B" #1 Well No. \_\_\_\_\_  
Office Address Bartlesville, Oklahoma  
Character of Well (completed as Oil, Gas or Dry Hole) Dry Hole  
Date well completed 6-20-1953 19  
Application for plugging filed 7-10-1953 19  
Application for plugging approved 7-13-1953 19  
Plugging commenced 8-22-1953 19  
Plugging completed 8-26-1953 19  
Reason for abandonment of well or producing formation \_\_\_\_\_

If a producing well is abandoned, date of last production Dry Hole 19  
Was permission obtained from the Conservation Division or its agents before plugging was commenced? Yes

Name of Conservation Agent who supervised plugging of this well R. J. Phillipe  
Producing formation \_\_\_\_\_ Depth to top \_\_\_\_\_ Bottom \_\_\_\_\_ Total Depth of Well 3115 Feet  
Show depth and thickness of all water, oil and gas formations.

OIL, GAS OR WATER RECORDS

CASING RECORD

FORMATION	CONTENT	FROM	TO	SIZE	PUT IN	PULLED OUT
	Water	3036	2990	8-5/8"	520	None
	Water	2880	2860	5 1/2"	3114	1528'
	Water	2786	2758			

Describe in detail the manner in which the well was plugged, indicating where the mud fluid was placed and the method or methods used in introducing it into the hole. If cement or other plugs were used, state the character of same and depth placed, from \_\_\_\_\_ feet to \_\_\_\_\_ feet for each plug set.

Ran Baker plug to 2740'; Squeezed with 300 sacks of common cement to 3000#.  
Reclaimed 1528' of 5 1/2" casing; filled with heavy rotary mud using jelflake and fiber tex; Mud to 22' of surface; cement to 4' of surface at which point the casing was cut off and a steel cap was welded on.

(If additional description is necessary, use BACK of this sheet)  
Name of Plugging Contractor Daco Lease and Well Servicing Co.  
Address Borger Texas

STATE OF Kansas, COUNTY OF Seward, ss.  
\_\_\_\_\_, (employee of owner) or (owner or operator) of the above-described well, being first duly sworn on oath, says: That I have knowledge of the facts, statements, and matters herein contained and the log of the above-described well as filed and that the same are true and correct. So help me God.

(Signature) H.V. Anderson  
Box 70 Liberal, Kansas  
(Address)

SUBSCRIBED AND SWORN TO before me this 29th day of August, 19 53

My commission expires 5-23-1957

J. T. Mabrey  
Notary Public.

PLUGGING  
FILE SEC 24 T 34 R 42W  
BOOK PAGE 114 LINE 2

RECEIVED  
STATE CORPORATION COMMISSION  
AUG 31 1953 8-31-53  
CONSERVATION DIVISION  
Wichita, Kansas