

WELL PLUGGING RECORD

Give All Information Completely
Make Required Affidavit
Mail or Deliver Report to:
Conservation Division
State Corporation Commission
212 No. Market
Wichita, Kansas

Morton County, Sec. 33 Twp. 34 Rge. 43 XX (W)

Location as "NE/CNW/SW" or footage from lines C NW

Lease Owner Panhandle Eastern Pipe Line Company

Lease Name Linscott Well No. 1

Office Address P. O. Box 828, Liberal, Kansas 67901

Character of Well (completed as Oil, Gas or Dry Hole) Gas

Date well completed January 13 1958

Application for plugging filed November 10 1969

Application for plugging approved November 12 1969


Plugging commenced November 13 1969

Plugging completed November 14 1969

Reason for abandonment of well or producing formation Excessive water, replacement well drilled

If a producing well is abandoned, date of last production 19

Was permission obtained from the Conservation Division or its agents before plugging was commenced? YES

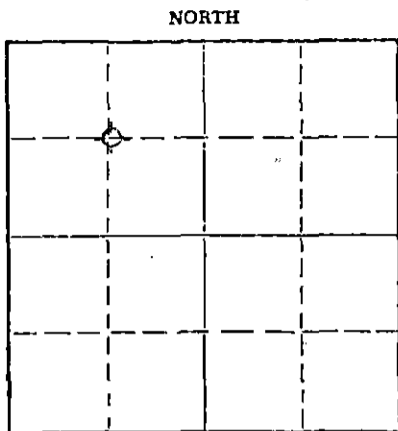

Locate well correctly on above Section Plat

Name of Conservation Agent who supervised plugging of this well Edgar J. Eves

Producing formation Greenwood Depth to top 2811 Bottom 2888 Total Depth of Well 3075 Feet

Show depth and thickness of all water, oil and gas formations.

OIL, GAS OR WATER RECORDS

CASING RECORD

FORMATION	CONTENT	FROM	TO	SIZE	PUT IN	PULLED OUT
Greenwood	Gas & Water	2811'	2999'	7"	604'	0
				4.5"	3068'	1100'

Describe in detail the manner in which the well was plugged, indicating where the mud fluid was placed and the method or methods used in introducing it into the hole. If cement or other plugs were used, state the character of same and depth placed, from _____ feet to _____ feet for each plug set.

Shot 4-1/2" casing at 1100'. Pulled 4-1/2" casing to 600'. Spotted 45 sacks cement. Pulled all casing. Spotted 15 sacks from 75 to 6'. Cut of surface pipe and welded on cap.

RECEIVED
STATE CORPORATION COMMISSION
NOV 26 1969
CONSERVATION DIVISION
Wichita, Kansas

(If additional description is necessary, use BACK of this sheet)

Name of Plugging Contractor Sargent's Casing Pulling Service

Address P. O. Box 506, Liberal, Kansas 67901

STATE OF Kansas COUNTY OF Seward

L. Jack P. Phillippe, (employee of ~~owner~~ ^{SS} Panhandle Eastern Pipe Line Co.) (owner or operator) of the above-described

well, being first duly sworn on oath, says: That I have knowledge of the facts, statements, and matters herein contained and the log of the above-described well as filed and that the same are true and correct. So help me God.

(Signature) [Signature]

L. Jack P. Phillippe, Manager, Drilg. & Prod.
P. O. Box 828, Liberal, Kansas 67901.

(Address)

SUBSCRIBED AND SWORN to before me this 25th day of November, 1969

My Commission Expires November 12, 1972

My commission expires _____

[Signature] Notary Public.