

STATE OF KANSAS
STATE CORPORATION COMMISSION


Give All Information Completely
Make Required Affidavit
Mail or Deliver Report to:
Conservation Division
State Corporation Commission
800 Bitting Building
Wichita, Kansas

WELL PLUGGING RECORD

Morton County, Sec. 32 Twp. 34 Rge. 43 (E) (W)

Location as "NE/CNW/SW" or footage from lines C NW NE
Lease Owner Musgrove Petroleum Corporation
Lease Name WIKER Well No. 3
Office Address 518 Petroleum Bldg., Wichita, Kansas.
Character of Well (completed as Oil, Gas or Dry Hole) Dry
Date well completed April 17, 1955 19
Application for plugging filed verbally - April 16, 1955 19
Application for plugging approved verbally - April 16, 1955 19
Plugging commenced April 17, 1955 19
Plugging completed April 17, 1955 19
Reason for abandonment of well or producing formation Dry

NORTH

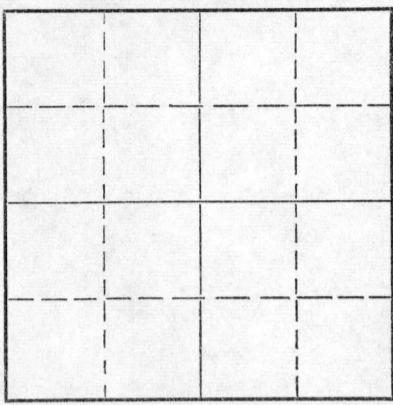

Locate well correctly on above
Section Plat

If a producing well is abandoned, date of last production _____ 19____
Was permission obtained from the Conservation Division or its agents before plugging was commenced? verbally - yes

Name of Conservation Agent who supervised plugging of this well M. A. Rives, Pratt, Kansas
Producing formation _____ Depth to top _____ Bottom _____ Total Depth of Well 4510' Feet
Show depth and thickness of all water, oil and gas formations.

OIL, GAS OR WATER RECORDS

CASING RECORD

FORMATION	CONTENT	FROM	TO	SIZE	PUT IN	PULLED OUT
				8-5/8"	1218.80'	

Describe in detail the manner in which the well was plugged, indicating where the mud fluid was placed and the method or methods used in introducing it into the hole. If cement or other plugs were used, state the character of same and depth placed, from _____ feet to _____ feet for each plug set.

Filled hole with mud to 500'.
Set 1st plug at 500' w/25 sx cement.
Filled hole with mud to 35'.
Set 2nd plug at 35' w/10 sx cement.

(If additional description is necessary, use BACK of this sheet)

Name of Plugging Contractor Musgrove Petroleum Corporation
Address 518 Petroleum Building, Wichita, Kansas.

STATE OF Kansas, COUNTY OF Sedgwick,
I, Gordon L. Koelling (employee of owner) or (owner or operator) of the above-described well, being first duly sworn on oath, says: That I have knowledge of the facts, statements, and matters herein contained and the log of the above-described well as filed and that the same are true and correct. So help me God.

(Signature) Gordon L. Koelling
518 Petroleum Building, Wichita, Kansas.
(Address)

SUBSCRIBED AND SWORN TO before me this 25th day of April, 1955

My commission expires September 24, 1956.

Walter D. Stensmyr
Notary Public.

PLUGGING
FILE SEC 32 T 34 R 43W
BOOK PAGE 113 LINE 19

RECEIVED
STATE CORPORATION COMMISSION
APR 27 1955 4-27-55
CONSERVATION DIVISION
Wichita, Kansas

CONTRACTOR'S WELL LOG

COMPANY: Musgrove Petroleum Corporation
 CONTRACTOR: Musgrove Petroleum Corporation
 FARM: WIKER #3
 LOCATION: C NW NE, Sec. 32-34-43
 Morton County, Kansas
 COMMENCED: April 4, 1955
 COMPLETED: April 17, 1955

0	90	Surface soil & sand
90	270	Red shale & lime shells
270	460	Red shale & red bed & lime stks.
460	651	Red bed, sand stks. & lime
651	700	Anhydrite & lime shells
700	768	Red bed, red shale & lime stks.
768	815	Anhydrite, lime shells, sand stks.
815	865	Lime & shells
865	980	Sand & shale
980	1020	Lime & shale
1020	1183	Shale & Red bed
1183	1220	Red bed, anhydrite stks & sand
1220	1225	Anhydrite
1225	1460	Anhydrite, sand & shale
1460	1750	Shale & shells
1750	2140	Sandy shale
2140	2480	Shale & lime
2480	2543	Red shale & lime streaks
2543	3905	Shale & lime
3905	3925	Lime
3925	4170	Shale & lime
4170	4255	Shale, lime & sand
4255	4260	Sand & shale
4260	4328	Lime & shale
4328	4510	Shale, lime & sand structure
	4510	Rotary Total Depth

Set 8-5/8" surface at 1218.80' with 600 sacks Posmix, 2% calcium chloride.
 Dry and Abandoned

STATE OF KANSAS)
) SS
 COUNTY OF SEDGWICK)

I, GORDON L. KOELLING, do hereby certify that the above and foregoing is a true and correct copy of the log of the WIKER #3, C NW NE, Section 32-34-43, Morton County, Kansas, as reflected by the files of the Musgrove Petroleum Corporation.

MUSGROVE PETROLEUM CORPORATION
 BY: *Gordon L. Koelling*
 Secretary-Treasurer

Subscribed and sworn to before me, a Notary Public, in and for Sedgwick County, Kansas, this 25th day of April, 1955.

John S. Stinson
 Notary Public

My commission expires September 24, 1956.

PLUGGING
 FILE NO. 32-34-43W
 PAGE 113 LINE 19

APR 27 1955
 CONSERVATION DIVISION
 Wichita, Kansas