


STATE OF KANSAS  
STATE CORPORATION COMMISSION

WELL PLUGGING RECORD

Give All Information Completely  
Make Required Affidavit  
Mail or Deliver Report to:  
Conservation Division  
State Corporation Commission  
212 No. Market  
Wichita, Kansas

Morton County, Sec. 32 Twp. 34S Rge. (E) 43 (W)  
Location as "NE/CNW/SW" or footage from lines. Approx C S/2 SW/4

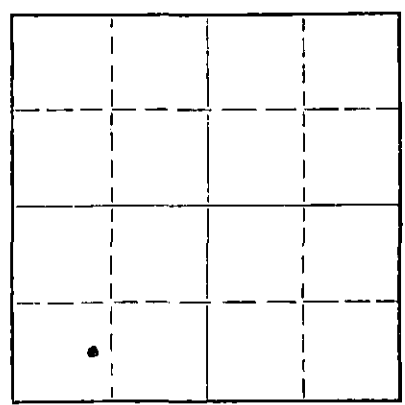

Locate well correctly on above Section Plat

Lease Owner Anadarko Production Company  
Lease Name Linscott "B" Well No. 3  
Office Address Box 351 Liberal, Kansas 67901  
Character of Well (completed as Oil, Gas or Dry Hole) Oil  
Date well completed 7/13 1962  
Application for plugging filed 12/9 1971  
Application for plugging approved 12/15 1971  
Plugging commenced 12/18 1971  
Plugging completed 12/20 1971

Reason for abandonment of well or producing formation Uneconomical to produce due to high water production.

If a producing well is abandoned, date of last production 19

Was permission obtained from the Conservation Division or its agents before plugging was commenced? Yes

Name of Conservation Agent who supervised plugging of this well Mr. Ed Eves  
Producing formation Upper Morrow Depth to top Bottom Total Depth of Well 4590 Feet

Show depth and thickness of all water, oil and gas formations.

OIL, GAS OR WATER RECORDS

CASING RECORD

FORMATION	CONTENT	FROM	TO	SIZE	PUT IN	PULLED OUT
				8 5/8	1239	NONE
				5 1/2	4548	2828'

Describe in detail the manner in which the well was plugged, indicating where the mud fluid was placed and the method or methods used in introducing it into the hole. If cement or other plugs were used, state the character of same and depth placed, from feet to feet for each plug set.

Spotted 25 sxs. cement @ 3616'.  
Spotted 35 sxs. cement from 1000 to 900'.  
Spotted 15 sxs. cement from 45' to surface.

RECEIVED  
STATE CORPORATION COMMISSION  
JAN 13 1972  
CONSERVATION DIVISION  
Wichita, Kansas


(If additional description is necessary, use BACK of this sheet)

Name of Plugging Contractor Sargent's Casing Pulling Service  
Address Box 506 Liberal, Kansas 67901

STATE OF KANSAS COUNTY OF SEWARD ss.  
V. K. DOWNEY (employee of owner) or (owner or operator) of the above-described well, being first duly sworn on oath, says: That I have knowledge of the facts, statements, and matters herein contained and the log of the above-described well as filed and that the same are true and correct. So help me God.

(Signature) *V. K. Downey*  
V. K. DOWNEY SUPERINTENDENT  
BOX 351 LIBERAL, KANSAS 67901 (Address)

SUBSCRIBED AND SWORN to before me this 12th day of January 1972  
September 9, 1972  
*Norman H. Spencer* Notary Public.

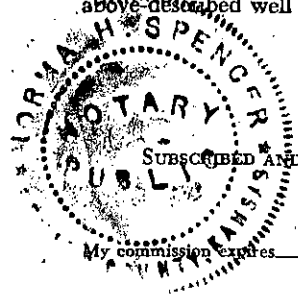

DRILLER'S LOG

WELL NAME Linscott "B" #3 COMPANY OPERATING Anadarko Production Company  
 ADDRESS of COMPANY Box 351, Liberal, Kansas  
 WELL LOCATION Apk. C 1/2 S/2 1/2 SW 1/4,  
680 ft. North of South line,  
1100 ft. East of West line; Sec. 37 Twp. 34 Rge. 43, Morton County, Kansas  
 DRILLING STARTED May 23, 1962 DRILLING COMPLETED June 7, 1962  
 WELL COMPLETED July 13, 1962 WELL CONNECTED \_\_\_\_\_, 19\_\_\_\_  
 ELEVATION 3542 ft. Ground Level CHARACTER OF WELL (Oil, Gas, or Dry Hole) Gas

OIL OR GAS SANDS OR ZONES		PERFORATIONS - ACIDIZING AND FRACTURING INFORMATION			
Name	From	To	No. of Shots	Gallons Used	Kind Used
Upper Morrow		4187	Triple Frac Notch	500	7 1/2%
				F/1500 Gals. Gelled Lease Oil	
				w/7500 lbs. Sand	

CASING RECORD

Size	Amount Set	Sacks of Cement	Amount Pulled
8 5/8	1239	600	---
5 1/2	4548	125	---

FORMATION RECORD

Formation	Top	Bottom	Formation	Top	Bottom
Surface Sand	0	31			
Surface Sand & Clay	31	263			
Surface Sand	263	613			
Red Bed & Gypsum	613	905			
Sand & Shale	905	1018			
Shale & Shells	1018	1230			
Anhydrite	1230	1240			
Shale & Shells	1240	2450			
Lime & Shale	2450	4590			
Total depth	4590				

RECEIVED  
 STATE CONSERVATION COMMISSION  
 DEC 15 1971  
 CONSERVATION DIVISION  
 Wichita, Kansas

RESULTS of INITIAL PRODUCTION TEST: July 13, 1962 - State test, WHACF 4,100 MCF  
SICP 702 PSIG, GOR 35,350 Cu. ft. per barrel.