


STATE OF KANSAS  
STATE CORPORATION COMMISSION

Give All Information Completely  
Make Required Affidavit  
Mail or Deliver Report to:  
Conservation Division  
State Corporation Commission  
212 No. Market  
Wichita, Kansas

WELL PLUGGING RECORD

NORTH

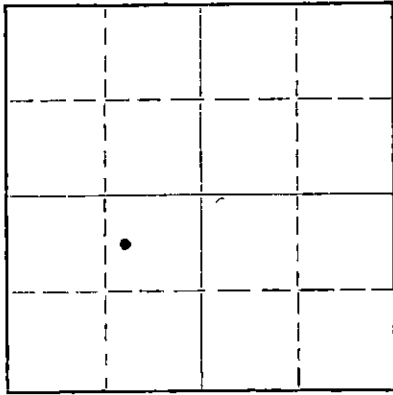

Locate well correctly on above  
Section Plat

Morton County, Sec. 32 Twp. 34S Rge. (E) 43 (W)

Location as "NE/CNW/SW" or footage from lines. 600'S & 1170'W of C

Lease Owner Anadarko Production Company

Lease Name Linscott "B" Well No. 2

Office Address Box 351 Liberal, Kansas 67901

Character of Well (completed as Oil, Gas or Dry Hole) Oil

Date well completed 5/28 1962

Application for plugging filed 12/9 1971

Application for plugging approved 12/15 1971

Plugging commenced 12/10 1971

Plugging completed 12/13 1971

Reason for abandonment of well or producing formation Uneconomical to produce due to high water production.

If a producing well is abandoned, date of last production 19

Was permission obtained from the Conservation Division or its agents before plugging was commenced? Yes

Name of Conservation Agent who supervised plugging of this well Mr. Ed Eves

Producing formation Purdy Morrow Depth to top Bottom Total Depth of Well 4630 Feet

Show depth and thickness of all water, oil and gas formations.

OIL, GAS OR WATER RECORDS

CASING RECORD

FORMATION	CONTENT	FROM	TO	SIZE	PUT IN	PULLED OUT
				8 5/8	1242	NONE
				4 1/2	4260	2601'

Describe in detail the manner in which the well was plugged, indicating where the mud fluid was placed and the method or methods used in introducing it into the hole. If cement or other plugs were used, state the character of same and depth placed, from feet to feet for each plug set.

Spotted 25 sxs. cement @ 3511'.  
Spotted 35 sxs. cement from 1000' to 900'.  
Spotted 15 sxs. cement from 45' to surface.

RECEIVED  
STATE CORPORATION COMMISSION  
JAN 13 1972  
CONSERVATION DIVISION  
Wichita, Kansas

(If additional description is necessary, use BACK of this sheet)

Name of Plugging Contractor Sargent's Casing Pulling Service

Address Box 506 Liberal, Kansas 67901

STATE OF KANSAS, COUNTY OF SEWARD, ss.

V. K. DOWNEY

(employee of owner) or (owner or operator) of the above-described

well, being first duly sworn on oath, says: That I have knowledge of the facts, statements, and matters herein contained and the log of the

above-described well as filed and that the same are true and correct. So help me God.


(Signature) V. K. DOWNEY

BOX 351 LIBERAL, KANSAS 67901

(Address)

SUBSCRIBED AND SWORN to before me this 12th day of January, 1972

September 9, 1972

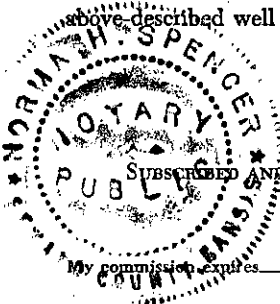

Norma H. Spencer  
Notary Public.

DRILLER'S LOG

WELL NAME Linscott "B" #2 COMPANY OPERATING Anadarko Production Company  
 ADDRESS of COMPANY Box 351, Liberal, Kansas  
 WELL LOCATION Apr. C 1/2 N 1/2 W 1/2,  
2040 ft. North of South line,  
1470 ft. East of West line; Sec. 32 Twp. 34 Rge. 43, Morton County, Kansas  
 DRILLING STARTED May 5, 19 62 DRILLING COMPLETED May 2, 19 62  
 WELL COMPLETED May 28, 19 62 WELL CONNECTED \_\_\_\_\_, 19 \_\_\_\_\_  
 ELEVATION 3539 ft. Ground Level CHARACTER OF WELL (Oil, Gas, or Dry Hole) Oil

OIL OR GAS SANDS OR ZONES - PERFORATIONS - ACIDIZING AND FRACTURING INFORMATION					
Name	From	To	No. of Shots	Gallons Used	Kind Used
<b>Purdy Morrow</b>	<b>4196</b>	<b>4202</b>	<b>26</b>	<b>Δ/500</b>	<b>7 1/2 MCA</b>
				<b>Δ/7,500 gelled lease oil</b>	
				<b>Δ/7,500 sand</b>	

CASING RECORD

Size	Amount Set	Sacks of Cement	Amount Pulled
<b>8 5/8</b>	<b>1242</b>	<b>550</b>	<b>--</b>
<b>6 1/2</b>	<b>4260</b>	<b>125</b>	<b>--</b>

FORMATION RECORD

Formation	Top	Bottom	Formation	Top	Bottom
Sand	0	225			
Shale & Shells	225	600			
Red Bed & Gypsum	600	1170			
Shale & Gypsum	1170	1243			
Red Bed	1243	1320			
Red Bed & shale	1320	1730			
Shale & Shells	1730	2460			
Lime & Shale	2460	4180			
Lime, Shale & Sand	4180	4216			
Lime & Shale	4216	4590			
Sand & Shale	4590	4630			
Total Depth	4630				

RECEIVED  
 STATE CORPORATION COMMISSION  
 DEC 15 1971  
 CONSERVATION DIVISION  
 Wichita, Kansas

RESULTS of INITIAL PRODUCTION TEST: May 28, 1962, flowed 132 BO in 7 1/2 hours.