


Give All Information Completely
Make Required Affidavit
Mail or Deliver Report to:
Conservation Division
State Corporation Commission
212 No. Market
Wichita, Kansas

WELL PLUGGING RECORD

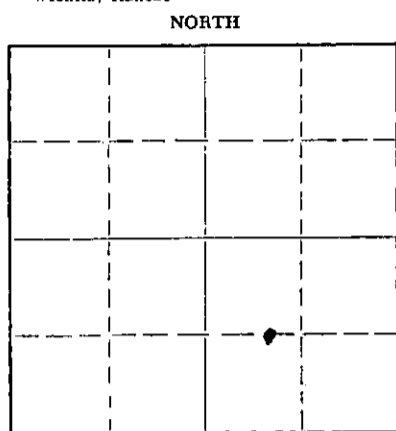

Locate well correctly on above
Section Plat

Morton County, Sec. 32 Twp. 34S Rge. 43 (E) W (W)
Location as "NE/CNW/SW" or footage from lines 1320' FSL & 1650' FEL
Lease Owner Anadarko Production Company
Lease Name Linscott "B" Well No. 1
Office Address Box 351 Liberal, Kansas 67901
Character of Well (completed as Oil, Gas or Dry Hole) Gas
Date well completed 4-6 19 61
Application for plugging filed 6-12 19 69
Application for plugging approved 6-17 19 69
Plugging commenced 7-3 19 69
Plugging completed 7-4 19 69
Reason for abandonment of well or producing formation uneconomical

If a producing well is abandoned, date of last production March 19 67
Was permission obtained from the Conservation Division or its agents before plugging was commenced? Yes

Name of Conservation Agent who supervised plugging of this well Edgar J. Eves
Producing formation Topeka Depth to top 2801' Bottom 2824' Total Depth of Well 3035 Feet
Show depth and thickness of all water, oil and gas formations.

OIL, GAS OR WATER RECORDS

CASING RECORD

FORMATION	CONTENT	FROM	TO	SIZE	PUT IN	PULLED OUT
Topeka	Gas	2801'	24'	8 5/8"	596'	None
				4 1/2"	2940'	500'

Describe in detail the manner in which the well was plugged, indicating where the mud fluid was placed and the method or methods used in introducing it into the hole. If cement or other plugs were used, state the character of same and depth placed, from _____ feet to _____ feet for each plug set.

Pulled Rods and Tubing
Mixed 15 sacks cement
Pumped plug with mud to 2600'
Shot 4 1/2" casing at 2350' and 1100'
Worked pipe free at 1100'
Pulled 4 1/2" casing to 600'
Spotted 35 sacks cement from 600' - 500'
Spotted 10 sacks cement from 30' - 0'
Completed 1:30 P.M. 7-4-69


RECEIVED
STATE CORPORATION COMMISSION
JUL 11 1969
CONSERVATION DIVISION
Wichita, Kansas

(If additional description is necessary, use BACK of this sheet)
Name of Plugging Contractor Sargents Casing Pulling Service
Address 102 W. Walnut Liberal, Kansas 67901

STATE OF Kansas, COUNTY OF Seward, ss.
_____, (employee of owner) or (owner or operator) of the above-described well, being first duly sworn on oath, says: That I have knowledge of the facts, statements, and matters herein contained and the log of the above-described well as filed and that the same are true and correct. So help me God.

(Signature) V. K. Downey
V. K. Downey
Box 351 Liberal, Kansas 67901
(Address)

SUBSCRIBED AND SWORN to before me this 9th day of July, 19 69

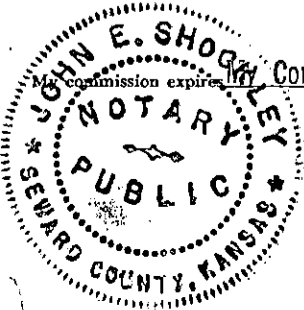

John E. Shockley
John E. Shockley Notary Public.

DRILLER'S LOG

WELL NAME: Edinscott #2 1-32 ; COMPANY OPERATING: Panhandle Eastern Pipe Line Co:
 ADDRESS of COMPANY: Box 351, Liberal, Kansas:

WELL LOCATION: 1/4 1/4 SE 1/4,
1320 ft. North of South line,
3632 ft. East of West line; Sec. 32, Twp. 36S, Rge. 43W, Maxton County, Kansas

DRILLING STARTED March 30, 19 61; DRILLING COMPLETED April 6, 19 61
 WELL COMPLETED April 17, 19 61; WELL CONNECTED _____, 19 _____

ELEVATION: 3523.3 ft. Ground Level; CHARACTER OF WELL (Oil, Gas, or Dry Hole) Gas

OIL OR GAS SANDS OR ZONES - PERFORATIONS - ACIDIZING AND FRACTURING INFORMATION					
Name	From	To	No. of Shots	Gallons Used	Kind Used
Topcote	2501	24	60	1000	35%

RECEIVED
 STATE CORPORATION COMMISSION
 JUN 17 1969
 CONSERVATION DIVISION
 Wichita, Kansas

CASING RECORD

Size	Amount Set	Sacks of Cement	Amount Pulled
2-5/8"	595'	350	None
4-1/2"	2940'	90	None

FORMATION RECORD

Formation	Top	Bottom	Formation	Top	Bottom
Surface Soil, Sand & Gravel	0	130			
Red Bed	130	370			
Red Bed & Gypsum	370	601			
Gypsum	601	870			
Sand	870	986			
Shale & Gypsum	986	1095			
Anhydrite	1095	1115			
Shale & Anhydrite Strakes	1115	1225			
Shale & Lime	1225	2420			
Lime	2420	2826			
Shale & Lime	2826	2930			
Lime	2930	3035			
Total Depth	3035				

RESULTS of INITIAL PRODUCTION TEST: 12 Hour test Gas: 2000 M380 plus 75 gal. water per hour