


STATE OF KANSAS  
STATE CORPORATION COMMISSION

WELL PLUGGING RECORD

Give All Information Completely  
Make Required Affidavit  
Mail or Deliver Report to  
Conservation Division  
State Corporation Comm.  
245 North Water  
Wichita, KS 67202

Morton County, Sec. 32 Twp. 34S Rge. 43 &W  
Location as "NE/4NW/4SW/4" or footage from lines  
C N/2 SE/4 NW/4

Lease Owner Unitized-Anadarko Production Co., Operator  
Lease Name INTERSTATE UNIT Well No. 75  
Office Address P. O. Box 351, Liberal, Kansas 67901  
Character of Well (Completed as Oil, Gas or Dry Hole)

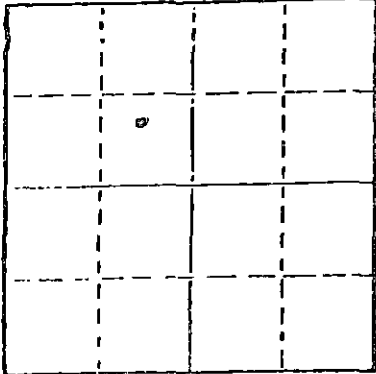

Locate well correctly on above  
Section Plat

Oil  
Date Well completed April 7 1956  
Application for plugging filed May 22 1979  
Application for plugging approved May 25 1979  
Plugging commenced July 18 1979  
Plugging completed July 18 1979  
Reason for abandonment of well or producing formation  
Casing in bad condition, uneconomical to produce  
If a producing well is abandoned, date of last production  
August 1968

Was permission obtained from the Conservation Division or  
its agents before plugging was commenced? yes

Name of Conservation Agent who supervised plugging of this well Clarence Thomas  
Producing formation Purdy Morrow Depth to top 4198 Bottom 4240 Total Depth of Well 4518  
Show depth and thickness of all water, oil and gas formations.

OIL, GAS OR WATER RECORDS

CASING RECORD

FORMATION	CONTENT	FROM	TO	SIZE	PUT IN	PULLED OUT
				8-5/8"	1248	None
				5-1/2"	4510	None

Describe in detail the manner in which the well was plugged, indicating where the mud fluid  
was placed and the method or methods used in introducing it into the hold. If cement or other  
plugs were used, state the character of same and depth placed, from \_\_\_\_\_ feet to  
\_\_\_\_\_ feet for each plug set.

- Spotted 25 sxs common cmt 4292-4080'
- 110 sxs common cmt TOC 2707'
- 50 sxs common cmt TOC 1126'
- 15 sxs common cmt 60-0'

STATE RECEIVED  
CONSERVATION COMMISSION  
AUG 15 1979  
WICHITA, KANSAS  
8-15-79

(If additional description is necessary, use BACK of this sheet)

Name of Plugging Contractor Halliburton Services

STATE OF KANSAS COUNTY OF SEWARD, ss.  
Paul Campbell (employee of owner) or (owner or operator)

of the above-described well, being first duly sworn on oath, says: That I have knowledge of  
the facts, statements, and matters herein contained and the log of the above-described well  
as filed and that the same are true and correct. So help me God.

(Signature)


*Paul Campbell*

P. O. Box 351, Liberal, Kansas 67901  
(Address)

SUBSCRIBED AND SWORN TO before me this 14<sup>th</sup> day of August, 1979

*Beverly J. Williams*

Notary Public.

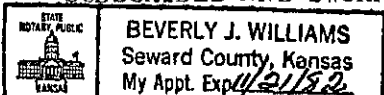

My commission expires November 21, 1982