

15-129-10582-0000

STATE OF KANSAS
STATE CORPORATION COMMISSION


00-00

Give All Information Completely
Make Required Affidavit
Mail or Deliver Report to:
Conservation Division
State Corporation Commission
211 No. Broadway
Wichita, Kansas

WELL PLUGGING RECORD

Morton County. Sec. 30 Twp. 34S Rge. 43 (E) W (W)

Location as "NE/CNW4SW4" or footage from lines C SE NE
Lease Owner Stanolind Oil and Gas Company
Lease Name Frank H. Scott Well No. 1
Office Address Box 591 Tulsa, Oklahoma
Character of Well (completed as Oil, Gas or Dry Hole) Dry Hole
Date well completed 1-18 1956
Application for plugging filed 1-17 1956
Application for plugging approved 1-19 1956
Plugging commenced 1-18 1956
Plugging completed 1-18 1956
Reason for abandonment of well or producing formation No commercial production encountered

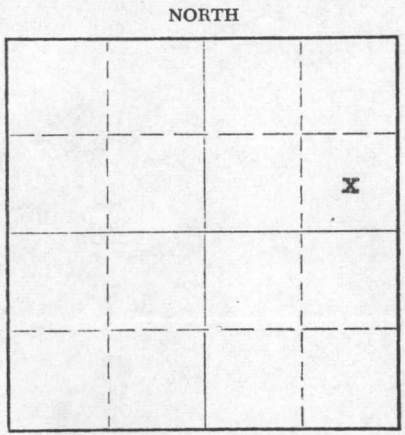

Locate well correctly on above Section Plat

If a producing well is abandoned, date of last production --- 19---
Was permission obtained from the Conservation Division or its agents before plugging was commenced? Yes

Name of Conservation Agent who supervised plugging of this well Mr. M.A. Rives Box 8 Pratt, Kansas
Producing formation None Depth to top --- Bottom --- Total Depth of Well 4600 Feet
Show depth and thickness of all water, oil and gas formations.

OIL, GAS OR WATER RECORDS

CASING RECORD

FORMATION	CONTENT	FROM	TOP	SIZE	PUT IN	PULLED OUT
Topeka	No Comm. Prod.		2722	8-5/8"	1205'	None
Lansing		2956			
Marmaton		3648			
Purdy		4210			
Keys		4520			
Mississippi		4574			

Describe in detail the manner in which the well was plugged, indicating where the mud fluid was placed and the method or methods used in introducing it into the hole. If cement or other plugs were used, state the character of same and depth placed, from _____ feet to _____ feet for each plug set.

Run drill pipe to bottom and spotted heavy mud. Pulled 600' drill pipe, spotted 35 sacks common cement at 4000', displaced through drill pipe with mud. Laid down drill pipe and pumped hole full of heavy mud. Spotted HOWCO plug 35' below bottom of cellar, filled to bottom of cellar with cement. Dumped 1/2 sack of cottonseed hulls and welded steel plate over 8-5/8" Casing.

(If additional description is necessary, use BACK of this sheet)

Name of Plugging Contractor Halliburton Oil Well Cementing Company
Address Duncan, Oklahoma

STATE OF Kansas, COUNTY OF Grant, ss.
W. M. Warren (employee of owner) or (owner or operator) of the above-described well, being first duly sworn on oath, says: That I have knowledge of the facts, statements, and matters herein contained and the log of the above-described well as filed and that the same are true and correct. So help me God.

(Signature) W M Warren Field Supt.
Box 507 Ulysses, Kansas
(Address)

SUBSCRIBED AND SWORN TO before me this 24 day of January, 1956

My commission expires November 12, 1958
J.G. Cherry Notary Public.

PLUGGING
FILE SEC 30 T 34 R 43W
BOOK PAGE 32 LINE 25

JAN 27 1956
CONSERVATION DIVISION
Wichita, Kansas