

WELL PLUGGING RECORD

Give All Information Completely
Make Required Affidavit
Mail or Deliver Report to:
Conservation Division
State Corporation Commission
800 Bitting Building
Wichita, Kansas

Morton County. Sec. 30 Twp. 34S Rge. 43 ~~XXX~~ (W)

Location as "NE/CNW/SW" or footage from lines C SE/4 of SW/4

Lease Owner J. M. Huber Corp.

Lease Name Block B Well No. 1

Office Address Box 978, Liberal, Kansas

Character of Well (completed as Oil, Gas or Dry Hole) Dry Hole

Date well completed 8-29-55 1955

Application for plugging filed 8-29-55 1955

Application for plugging approved 8-29-55 1955


Plugging commenced 8-29-55 1955

Plugging completed 8-29-55 1955

Reason for abandonment of well or producing formation Dry hole

If a producing well is abandoned, date of last production _____ 19____

Was permission obtained from the Conservation Division or its agents before plugging was commenced? yes

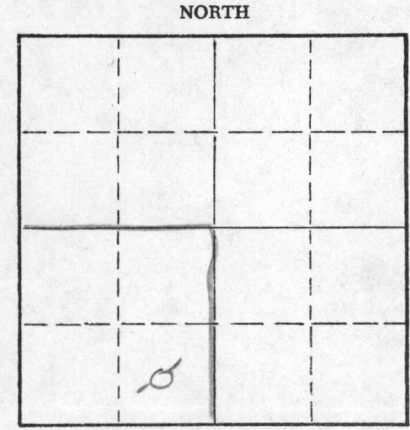

Locate well correctly on above Section Plat

Name of Conservation Agent who supervised plugging of this well M. A. Rives

Producing formation _____ Depth to top _____ Bottom _____ Total Depth of Well 4760 Feet

Show depth and thickness of all water, oil and gas formations.

OIL, GAS OR WATER RECORDS

CASING RECORD

FORMATION	CONTENT	FROM	TO	SIZE	PUT IN	PULLED OUT
				8-5/8"	1140	None

Describe in detail the manner in which the well was plugged, indicating where the mud fluid was placed and the method or methods used in introducing it into the hole. If cement or other plugs were used, state the character of same and depth placed, from _____ feet to _____ feet for each plug set.

Filled with mud. Pushed Halliburton Plug to 550'
w/D.P. Spotted 35 sacks of cement through drill
pipe. Mudded to 40'. Set Halliburton Plug and
cemented to surface with 15 sacks of cement.

RECEIVED
STATE CORPORATION COMMISSION
SEP - 2 1955
9-2-55
CONSERVATION DIVISION
Wichita, Kansas

(If additional description is necessary, use BACK of this sheet)

Name of Plugging Contractor J. M. Huber Corp.

Address Box 831, Borger, Texas

STATE OF KANSAS, COUNTY OF SEWARD, ss.

W. W. Henson (employee of owner) or (~~owner~~) of the above-described well, being first duly sworn on oath, says: That I have knowledge of the facts, statements, and matters herein contained and the log of the above-described well as filed and that the same are true and correct. So help me God.

(Signature) W. W. Henson
Box 978, Liberal, Kansas
(Address)

SUBSCRIBED AND SWORN to before me this 1 day of September, 1955

My commission expires 7-27-57

J. R. Keyler
Notary Public.

PLUGGING
FILE SEC 30-34-430
BOOK PAGE 146 LINE 14

Well Log
Block B #1
Page 2

STATE OF KANSAS, COUNTY OF SEWARD, ss:

W. W. Henson, employee of owner of the above-described well being first duly sworn on oath, says: That I have knowledge of facts, statements and matters herein contained and the log of the above-described well as filed and that the same are true and correct.

W. W. Henson

Subscribed and sworn to before me this 1 day of September, 1955.

L. Key Lee
Notary Public

My commission expires:
7-27-57

PLUGGING
FILE SEC Y R
BOOK PAGE LINK

NOTARY PUBLIC
STATE OF KANSAS
Seward County

WELL LOG

WELL NAME: Block B #1

WELL LOCATION: Center of SE/4 of SW/4 of Section 30, Township 34S, Range 43W, Morton County, Kansas.

WELL OWNER: J. M. Huber Corp.

DRILLING COMMENCED: 8-9-55

DRILLING COMPLETED: 8-29-55

WELL COMPLETED: 8-29-55

TOTAL DEPTH: 4760'

<u>FORMATION</u>	<u>DEPTH</u>
Sand	0 - 100
Sand, gyp and clay	100 - 150
Redbed and shells	150 - 665
Lime, shells and gyp	665 - 787
Redbed, lime and shale	787 - 993
Redbed and shells	993 - 1140
Shale, shells and redbed	1140 - 1480
Shale, lime and redbed	1480 - 2225
Lime and shale	2225 - 2621
Lime	2621 - 2971
Lime and shale	2971 - 3123
Lime	3123 - 3303
Lime and shale	3303 - 3581
Lime	3581 - 3666
Lime and shale	3666 - 3983
Lime, shale and chert	3983 - 4045
Lime and shale	4045 - 4216
Core #1 (shale)	4216 - 4227
Shale and lime	4227 - 4302
Lime, stringers and shale	4302 - 4398
Lime	4398 - 4471
Lime and shale	4471 - 4479
Lime, sand and shale	4479 - 4530
Core #2 (shaly sand and shale)	4530 - 4557
?	4557 - 4569
Core #3 (sand, shale and silt-stone)	4569 - 4598 1/2
Lime	4598 1/2 - 4760
Total Depth	4760

RECEIVED
STATE CORPORATION COMMISSION

SEP - 2 1955

CONSERVATION DIVISION
Wichita, Kansas

PLUGGING
 FILE SEC 30 & 34 R 43W
 BOOK PAGE 146 LINE 24