


15-025-00016-0000

WELL PLUGGING RECORD

Give All Information Completely
 Make Required Affidavit

COUNTY Morton SEC. 30 TWP. 34S RGE. 43W E/W
 Location as in quarters or footage from lines:
 SE SE

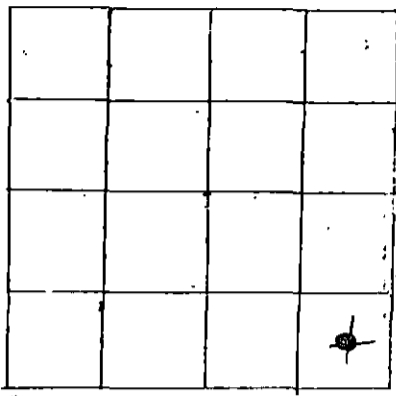

Lease Owner Energy Reserve Group
 Lease Name U S A Clinton F Well No. 1
 Office Address 3613 NW 56th Suite 210 Okla. City, Okla. 73112
 Character of Well (Completed as Oil, Gas or Dry Hole): Oil
 Date Well Completed MAY, 1935
 Application for plugging filed 4-12-84
 Plugging commenced 7-11-84
 Plugging completed 7-13-84
 Reason for abandonment of well or producing formation

Locate Well
 correctly on above
 Section Platt.

Depleted
 Was permission obtained from the Conservation Division or it's
 Agent's before plugging was commenced? Yes

Name of Conservation Agent who supervised plugging of this well Paul Luthi
 Producing formation Morrow G Depth to top 4454 bottom 60 T.D. 4545
 Show depth and thickness of all water, oil and gas formations.

OIL, GAS OR WATER RECORDS

Casing Record

Formation	Content	From	To	Size	Put in	Pulled Out
<u>Morrow G</u>	<u>Oil</u>	<u>4454</u>	<u>60</u>	<u>8 5/8</u>	<u>1224</u>	<u>none</u>
<u>PURDY</u>	<u>oil</u>	<u>4204</u>	<u>05</u>	<u>5 1/2</u>	<u>4544</u>	<u>1721</u>
<u>Cherokee</u>	<u>Gas</u>	<u>4018</u>	<u>30</u>			
<u>MARMPFON</u>	<u>DRY</u>	<u>3636</u>	<u>50</u>			

Describe in detail the manner in which the well was plugged, indicating where the mud fluid was placed and the method or methods used in introducing it into the hold. If cement or other plugs were used, state the character of same and depth placed, from _____ feet to _____ feet for each plug set.

Pump 25 sks. of cement @ 3686 to 3530
 Pump 50 sks. of cement @ 1270 to 1170
 Pump 30 sks. of cement @ 600 to 500
 Put 10 sks. of cement @ 40 to 0

RECEIVED
 STATE CORPORATION COMMISSION

JUL 31 1984

Cut off & cap 8 5/8 3' below ground level.

CONSERVATION DIVISION
 Wichita, Kansas

PURDY and Cherokee parts were squeezed in 1977

(If additional description is necessary, use BACK of this sheet)

Name of Plugging Contractor Sargents Casing Pulling Service Box 506 Liberal, Kansas 67901

STATE OF Okla. COUNTY OF Okla., ss.
Scott Sanders (employee of owner) or (owner or operator) of the
 above-described well, being first duly sworn on oath, says: That I have knowledge of the
 facts, statements, and matters herein contained and the log of the above-described well as
 filed and that the same are true and correct. So help me God.

(Signature) Scott Sanders

(Address)

SUBSCRIBED AND SWORN TO before me this 30 day of July, 19 84

[Signature]
 Notary Public.

My Commission expires: 2-28-86