


STATE OF KANSAS
STATE CORPORATION COMMISSION

WELL PLUGGING RECORD

Give All Information Completely
Make Required Affidavit
Mail or Deliver Report to:
Conservation Division
State Corporation Commission
211 No. Broadway
Wichita, Kansas

County. Sec. 10 Twp. 35S Rge. (E) 25(W)
Location as "NE/CNW/SW" or footage from lines 2309' NL & 3002' WL (SW SW NE)
Lease Owner Shell Oil Company
Lease Name L. THEIS Well No. 1
Office Address P. O. Box 426, Wichita 1, Kansas
Character of Well (completed as Oil, Gas or Dry Hole) Dry Hole
Date well completed June 2 19 56
Application for plugging filed June 11 19 56
Application for plugging approved June 12 19 56
Plugging commenced June 2 19 56
Plugging completed June 2 19 56
Reason for abandonment of well or producing formation Location commenced cratering.

NORTH

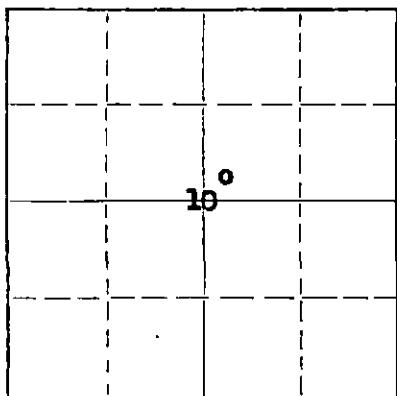

Locate well correctly on above
Section Plat

If a producing well is abandoned, date of last production _____ 19____
Was permission obtained from the Conservation Division or its agents before plugging was com-
menced? Yes (verbal)

Name of Conservation Agent who supervised plugging of this well M. A. Rives
Producing formation _____ Depth to top _____ Bottom _____ Total Depth of Well 447 Feet
Show depth and thickness of all water, oil and gas formations.

OIL, GAS OR WATER RECORDS

CASING RECORD

FORMATION	CONTENT	FROM	TO	SIZE	PUT IN	PULLED OUT
				20"	58'	None

Describe in detail the manner in which the well was plugged, indicating where the mud fluid was placed and the method or methods used in introducing it into the hole. If cement or other plugs were used, state the character of same and depth placed, from _____ feet to _____ feet for each plug set.

Filled hole with heavy mud from 447' to 23'.
Pumped in 40 sack cement, filling hole from
23' to 5'.

Note: Final plugging of this hole to surface
will be accomplished with rock and dirt
as directed by Mr. Rives.

(If additional description is necessary, use BACK of this sheet)

Name of Plugging Contractor Midwestern Drillers
Address Box 921, Liberal, Kansas

STATE OF KANSAS COUNTY OF SEDGWICK, ss.

R. F. Wicks (employee of owner) ~~not a conservator~~ of the above-described well, being first duly sworn on oath, says: That I have knowledge of the facts, statements, and matters herein contained and the log of the above-described well as filed and that the same are true and correct. So help me God.

(Signature) R. F. Wicks
P. O. Box 426, Wichita 1, Kansas
(Address)

SUBSCRIBED AND SWORN TO before me this 21st day of June, 19 56

My commission expires April 16, 1960

Ray Postlethwaite
RELEEV Notary Public.
STATE CORPORATION COMMISSION

1b

PLUGGING
FILE SEC. 10 T. 35 R. 25W
BOOK PAGE 70 LINE 24

JUN 22 1956
6-22-56
CONSERVATION DIVISION
Wichita, Kansas

SHELL-L. THEIS #1
2309'NL & 3002'WL Section 10-35S-25W
(Approximately SW SW NE)
Wildeat
Clark County, Kansas

Casing Record

20" cem 52' with 135 sax; cement
circulated.

- 0 - 15 surface soil
- 45 sand & gravel
- 100 sand & clay
- 447 red rock & gypsum T.D.

Note: Lost circulation at 422' and at 447';
location commenced cratering.

1b

STATE

PLUGGING
 FILE SEC 10 T. 35 R. 25W
 BOOK PAGE 70 LINE 24