


WELL PLUGGING RECORD

FORMATION PLUGGING RECORD

STATE OF KANSAS
 STATE CORPORATION COMMISSION
 Give All Information Completely
 Make Required Affidavit
 Mail or Deliver Report to:
 Conservation Division
 State Corporation Commission
 800 Bittling Building
 Wichita, Kansas

Strike out upper line
 when reporting plug-
 ging off formations.

Clark County Sec. 8 Twp. 35S Rge. 25W (E) W (W)
 Location as "NE $\frac{1}{4}$ NW $\frac{1}{4}$ SW $\frac{1}{4}$ " or footage from lines 1980 EWL & 1320 SNL CE/2 NW
 Lease Owner Ashland Oil & Refining Company
 Lease Name Theis Well No. 6
 Office Address P. O. Box 9695, 720 NW 50th St., Oklahoma City, Okla.
 Character of Well (completed as Oil, Gas or Dry Hole) Dry Hole
 Date well completed November 16 1962
 Application for plugging filed November 16 1962
 Application for plugging approved November 16 1962
 Plugging commenced November 17 1962
 Plugging completed 10:00 P.M. November 17 1962
 Reason for abandonment of well or producing formation Dry Hole

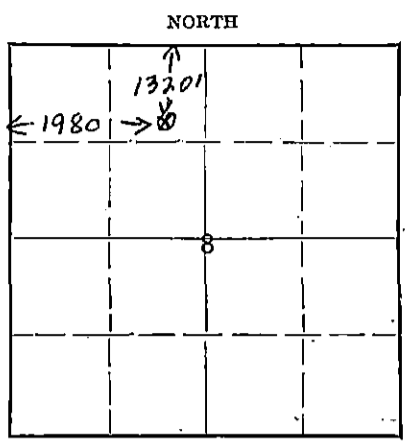

Locate well correctly on above
 Section Plat

If a producing well is abandoned, date of last production.....19.....
 Was permission obtained from the Conservation Division or its agents before plugging was com-
 menced? Yes

Name of Conservation Agent who supervised plugging of this well Hugh Scott, Liberal, Kansas
 Producing formation None Depth to top..... Bottom..... Total Depth of Well 6120' Feet
 Show depth and thickness of all water, oil and gas formations.

OIL, GAS OR WATER RECORDS

CASING RECORD

Formation	Content	From	To	Size	Put In	Pulled Out
				8 5/8"	723'	-0-

Describe in detail the manner in which the well was plugged, indicating where the mud fluid was placed and the method or methods used in introducing it into the hole. If cement or other plugs were used, state the character of same and depth placed, from.....feet to.....feet for each plug set.

Filled the hole with heavy mud to 710' to Total Depth, set a cement plug with 35 sacks of cement 710' to 600'.
Filled the hole with heavy mud to 600 to 45'. Set a cement plug, 15 sacks of cement, 45' to surface.
Welded cap on surface casing.

Posmix cement was used.

RECEIVED
 STATE CORPORATION COMMISSION
 NOV 20 1962 11-20-62
 CONSERVATION DIVISION
 Wichita, Kansas

(If additional description is necessary, use BACK of this sheet)

Correspondence regarding this well should be addressed to Ashland Oil & Refining Company,
 Address P. O. Box 9695, 720 Northwest 50th Street, Oklahoma City, Oklahoma

STATE OF Oklahoma, COUNTY OF Oklahoma, ss.

K. G. Calvery (employee of owner) or ~~owner or operator~~ of the above-described well, being first duly sworn on oath, says: That I have knowledge of the facts, statements, and matters herein contained and the log of the above-described well as filed and that the same are true and correct. So help me God.

(Signature) K. G. Calvery
P. O. Box 9695, Oklahoma City, Oklahoma
 (Address)

SUBSCRIBED AND SWORN TO before me this 19th day of November, 1962

Jane LaBue Whitfield
 Notary Public.

My commission expires 3-8-66

1320' SNL, 1980' EWL
 Sec. 8-35S-25W
 Clark County, Kansas

THEIS WELL NO. 6

Contractor: The R. W. Rine Drilling Company

STARTED: October 31, 1962

COMPLETED: November 17, 1962

L O G

Red Bed	0'	-	681'	
Red Bed, Gyp, & Sand	681'	-	925'	8-5/8" Csg. @723' w/600 Sx. Pozmix + 2% C. C.
Shale & Red Bed	925'	-	1500'	Totco @1000', 1/2°; @1500', 1/2°
Red Bed, Shale & Gyp	1500'	-	2127'	
Shale, Gyp, & Anhy. Stringers	2127'	-	2355'	Totco @2150', 0°;
Lime & Shale	2355'	-	3940'	
Shale	3940'	-	4345'	
Lime & Shale	4345'	-	4978'	Totco @4545', 1/4°
Lime	4978'	-	5853'	Totco @5440', 1/2°; @5448', 1/2°
Lime & Shale	5853'	-	5937'	
Lime	5937'	-	6042'	
Lime & Shale	6042'	-	6120'	T. D. D & A Plugged at 710 feet w/ 35 Sx. Cement and 45' w/15 Sx.

STATE OF KANSAS)
 COUNTY OF SEDGWICK) ss

I, R. M. Green, do hereby certify that the above is a true and accurate log of the Theis Well No. 6, located 1320' SNL, 1980' EWL of Section 8-35S-25W, Clark County, Kansas.


 Secretary-Treasurer

Subscribed and sworn to before me this 26th day of November, 1962.


 NOTARY PUBLIC

My Commission Expires: 6/14/66

RECEIVED
 STATE CORPORATION COMMISSION

NOV 29 1962

CONSERVATION DIVISION
 Wichita, Kansas