

STATE OF KANSAS
CORPORATION COMMISSION

WELL PLUGGING RECORD

All Information Completely
Required Affidavit
Mail or Deliver Report to:
Conservation Division
State Corporation Commission
212 North Market, Insurance Bldg.
Wichita, Kansas

Clark County, Sec. 7 Twp. 35S Rge. 25 (NW) W (W)

Location as "NE/CNW/SW" or footage from lines C SW/4 NE/4

Lease Owner Ashland Oil & Refining Company

Lease Name Theis Well No. 3

Office Address 720 NW 50th St., Oklahoma City, Oklahoma

Character of Well (completed as Oil, Gas or Dry Hole) Dry hole

Date well completed 1-26 1962

Application for plugging filed 1-26 1962

Application for plugging approved 1-26 1962

Plugging commenced 1-26 1962

Plugging completed 1-26 1962

Reason for abandonment of well or producing formation Dry-hole

If a producing well is abandoned, date of last production - - - 19 - -

Was permission obtained from the Conservation Division or its agents before plugging was commenced? Yes Verbal approval

Name of Conservation Agent who supervised plugging of this well Harold J. Hollis W. L. Lackamp, Jr.

Producing formation None Depth to top - - Bottom - - - - Total Depth of Well 6166' Feet

Show depth and thickness of all water, oil and gas formations.

OIL, GAS OR WATER RECORDS

CASING RECORD

FORMATION	CONTENT	FROM	TO	SIZE	PUT IN	PULLED OUT
N	Surface	8 5/8" 24# J-55	0'	561	8 5/8	561
O						
N						
E						
						None

Describe in detail the manner in which the well was plugged, indicating where the mud fluid was placed and the method or methods used in introducing it into the hole. If cement or other plugs were used, state the character of same and depth placed, from _____ feet to _____ feet for each plug set.

- 6166' - 547' Filled hole with mud.
- 547' - 442' Plugged with 35 sacks of cement
- 442' - 40' Filled with mud
- 40' - 0' Plugged with 15 sacks Cement

RECEIVED
STATE CORPORATION COMMISSION
FEB 2 1962
CONSERVATION DIVISION
Wichita, Kansas

(If additional description is necessary, use BACK of this sheet)

Name of Plugging Contractor Halliburton Oil Well Cementing Co.

Address Liberal, Kansas

STATE OF Oklahoma, COUNTY OF Oklahoma, ss.

(employee of owner) or (owner or operator) of the above-described well, being first duly sworn on oath, says: That I have knowledge of the facts, statements, and matters herein contained and the log of the above-described well as filed and that the same are true and correct. So help me God.

(Signature) K. G. Galvery *K. G. Galvery*
720 NW 50th, Oklahoma City, Okla.
(Address)

SUBSCRIBED AND SWORN TO before me this 30th day of January, 1962

My commission expires 11-3-63

Luth L. Logan
Notary Public.




STATE OF KANSAS
STATE CORPORATION COMMISSION

Give All Information Completely
Make Required Affidavit
Mail or Deliver Report to:
Conservation Division
State Corporation Commission
212 North Market, Insurance Bldg.
Wichita, Kansas

WELL PLUGGING RECORD

Clark County, Sec. 7 Twp. 35S Rge. 25 (NW) W (W)
Location as "NE/CNW/SW" or footage from lines C SW/4 NE/4
Lease Owner Ashland Oil & Refining Company
Lease Name Theis Well No. 3
Office Address 720 NW 50th St., Oklahoma City, Oklahoma
Character of Well (completed as Oil, Gas or Dry Hole) Dry hole
Date well completed 1-26 1962
Application for plugging filed 1-26 1962
Application for plugging approved 1-26 1962
Plugging commenced 1-26 1962
Plugging completed 1-26 1962
Reason for abandonment of well or producing formation Dry-hole

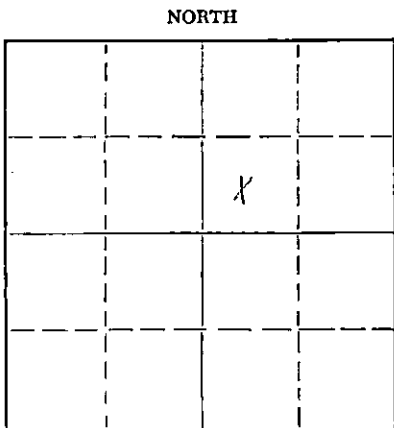

If a producing well is abandoned, date of last production - - - 19 - -
Was permission obtained from the Conservation Division or its agents before plugging was commenced? Yes Verbal approval

Name of Conservation Agent who supervised plugging of this well Harold J. Hollis W. L. Lackamp, Jr.
Producing formation None Depth to top - - - Bottom - - - - - Total Depth of Well 6166' Feet
Show depth and thickness of all water, oil and gas formations.

OIL, GAS OR WATER RECORDS

CASING RECORD

FORMATION	CONTENT	FROM	TO	SIZE	PUT IN	PULLED OUT
N	Surface	8 5/8" 24# J-55	0'	561	8 5/8	561
O						-0-
N						
E						
						None

Describe in detail the manner in which the well was plugged, indicating where the mud fluid was placed and the method or methods used in introducing it into the hole. If cement or other plugs were used, state the character of same and depth placed, from _____ feet to _____ feet for each plug set.

- 6166' - 547' Filled hole with mud.
- 547' - 442' Plugged with 35 sacks of cement
- 442' - 40' Filled with mud
- 40' - 0' Plugged with 15 sacks Cement

RECEIVED
STATE CORPORATION COMMISSION

FEB 2 1962

CONSERVATION DIVISION
Wichita, Kansas

(If additional description is necessary, use BACK of this sheet)

Name of Plugging Contractor Halliburton Oil Well Cementing Co.
Address Liberal, Kansas

STATE OF Oklahoma, COUNTY OF Oklahoma, ss.

(employee of owner) or (owner or operator) of the above-described well, being first duly sworn on oath, says: That I have knowledge of the facts, statements, and matters herein contained and the log of the above-described well as filed and that the same are true and correct. So help me God.

(Signature) K. G. Calvery *K. G. Calvery*
720 NW 50th, Oklahoma City, Okla.
(Address)

SUBSCRIBED AND SWORN TO before me this 30th day of January, 1962

My commission expires 11-3-63

Ruth L. Logan
Notary Public.

